IREDELL COUNTY HEALTH DEPARTMENT

Statesville Phone TR 3-7271 — Mooresville Phone NO 3-1271

PERMIT TO INSTALL SEPTIC TANK

Permit NO. _____ Permit Date 10/24 1962

Owner GOLF CLUB HOUSE (Sam McCOMBS) Address _____

Installed By GEORGE MAHAFFEY Address _____


Location of Property OUT BY UNITY SCHOOL PASS CEMETARY (COLORED) PASS NEGRO HOUSES — BEAR RIGHT — FOLLOW DIRT ROAD.

Tank		Capacity		Length of Lines		Fixtures	
Block	(X)	800	( )	150'	( )	No. of Baths	(2)
Precast	( )	900	( )	175'	( )	Dishwasher	( )
		1000	(X)	200'	( )	Garbage Grdr.	( )
		1100	( )	225'	(X)	Auto-Washer	( )
		1200	( )	250'	( )	Other	_____
		Other	_____	Other	_____		

NOTIFY HEALTH DEPARTMENT AT LEAST EIGHT HOURS BEFORE TANK IS TO BE INSPECTED.

Final Inspection 10/24 1962 Approved (✓) Disapproved ( )

Remarks _____

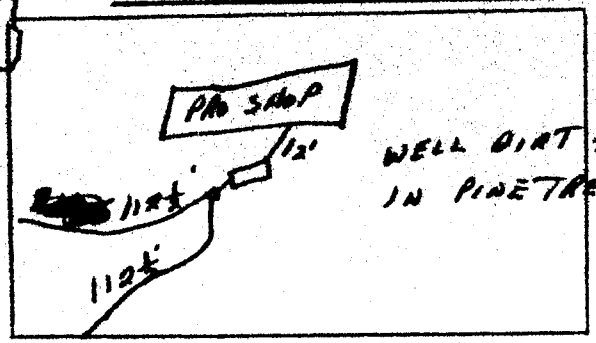

Sketch of Installation

Sanitarian