IREDELL COUNTY HEALTH DEPARTMENT

STATESVILLE 704-878-5305 MOORESVILLE 704-664-5281

IMPROVEMENT PERMIT / AUTHORIZATION TO CONSTRUCT / OPERATION PERMIT / EXISTING SYSTEM INSPECTION

PERMIT# 79461 PIN# 4754730490 DATE 3-8-99

OWNER OR CONTRACTOR VA CHA PHONE: Business Home 704 489 1113

ADDRESS 162 Twin oaks Rd Sta N.C.

LOCATION E. Greenbrair Turn Twin oaks 1/4 mi Rt

SUBDIVISION BLOCK / SECTION LOT LOT AREA 1.5 acres SITE CLASS PS DESIGN FLOW 360 L.T.A.R. .3

Septic Tank: 1000 Gallons; STB Date

Pump Tank: Gallons; PT Date

Pump Make: Model Serial No.

Nitrification Field: No Fields 1 Square Feet 400 Linear Feet 133

No Lines 1 Trench Width 36" Max Trench Bottom Depth 36" Gravel Depth 12"

New System Repair System Type: I II III IV V VI

System Description: Addition Conv. Gravity

Repair System Description: " "

Maintenance Agreement Required: Yes No

Slab Crawl Space Basement w/plumbing Basement wo/plumbing

House/Mod. Home No. Bedrooms 3

Mobile Home No. Bathrooms 2

Business No. Employees


Other

Water Supply: Individual Public Community


Comments/Conditions Adding To Bring up To 3 Bedroom Standards

Comments/Conditions

INITIAL SITE SKETCH

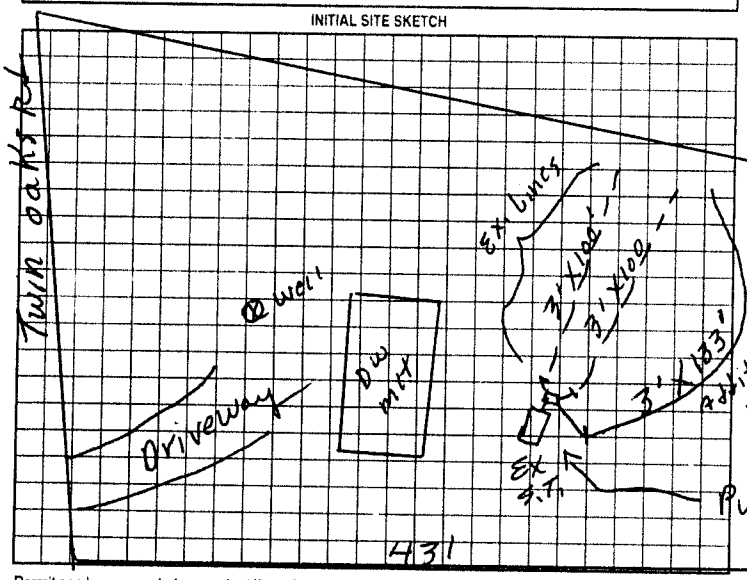

AS BUILT SKETCH

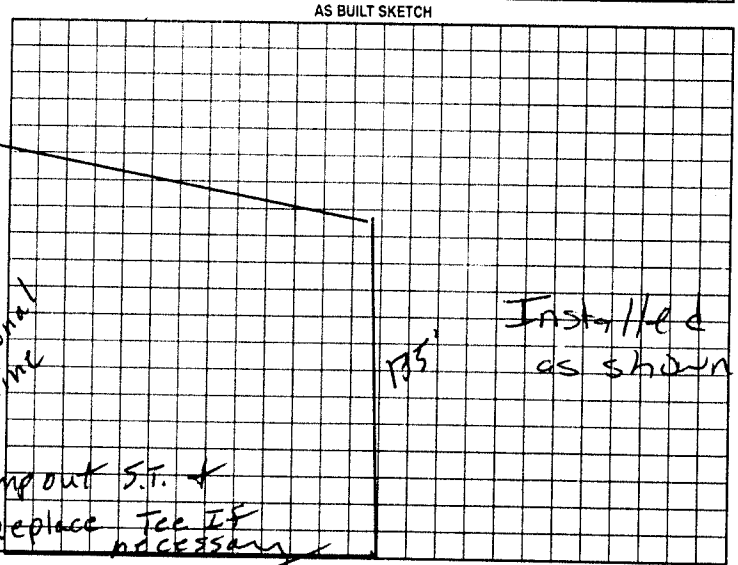

Permit can be suspended or revoked if any false information is supplied toward securing the permit/any unauthorized changes are made to the site/any unauthorized changes are made in the installation of the system. Improvement Permit with plat valid without expiration. Improvement Permit with site plan valid for sixty months. Authorization to Construct is valid for a period equal to that of Improvement Permit – not to exceed sixty months.

Signed: Norris Poindexter (Piedmont Housing) date

Improvement Permit by: P.C. moore date 3-8-99

Authorization to Construct by: P.C. moore date 3-8-99

Installed by: G & M Enterprises

Operation Permit by: Mark C. Ott RS date 3-29-99

Existing System Inspection by: date

HEALTH DEPT. COPY: WHITE OWNER COPY (FINAL): YELLOW OWNER COPY (INITIAL): PINK