IREDELL COUNTY HEALTH DEPARTMENT

STATESVILLE 704-878-5305 (LI) MOORESVILLE 704-664-5281

IMPROVEMENT PERMIT / AUTHORIZATION TO CONSTRUCT / OPERATION PERMIT / EXISTING SYSTEM INSPECTION

PERMIT# 115394 PIN# 4754-73-5913 DATE 10-3-03

OWNER OR CONTRACTOR LUV HOMES OF TROUTMAN PHONE: Business 704-528-0848 Home

ADDRESS 1036 CHARLOTTE HIGHWAY, TROUTMAN NC 28166

LOCATION EAST SIDE DRIVE TO GREENBRIAR RD, TR TWIN OAKS DRIVE, TL COREY DRIVE, 5TH LOT ON LEFT

SUBDIVISION BLOCK / SECTION LOT LOT AREA 1.02 ACRES SITE CLASS. PS DESIGN FLOW 360 L.T.A.R. 0.25 GPD/FT²

Septic Tank: 1000 Gallons; STB 312 Date 6-8-03
Pump Tank: Gallons; PT Date
Pump Make: Model Serial No.
Nitrification Field: No Fields 1 Square Feet 1440 Linear Feet 360
No Lines FIVE Trench Width 36" Max Trench Bottom Depth 36" Gravel Depth N/A

☑ New System ☐ Repair System Type: I, II, (III), IV, V, VI
System Description: 25% REDUCTION, GRAVITY
Repair System Description: 25% REDUCTION, PUMP
Maintenance Agreement Required: ☐ Yes ☑ No


☑ House/Mod. Home No. Bedrooms 3
☐ Mobile Home No. Bathrooms 2
☐ Business No. Employees
☐ Other
☐ Slab ☑ Crawl Space ☐ Basement w/plumbing ☐ Basement wo/plumbing

Water Supply: ☐ Individual ☑ Public ☐ Community

Comments:/Conditions: ① NO CUTTING ALLOWED IN ORDER TO SET HOUSE ② INSTALL SUBSURFACE INTERCEPT DRAINAGE DITCH AS SHOWN BEGINNING 45' DEEP, AROUND SYSTEM, THEN OUT TO DAYLIGHT ③ INSTALL 25% REDUCTION SYSTEM ON CONTOUR

Comments:/Conditions: SEPTIC TANK WITH MARKER INSTALLED ~~ACCORDING~~ USING "ZABEL" FILTER

49.65' INITIAL SITE SKETCH

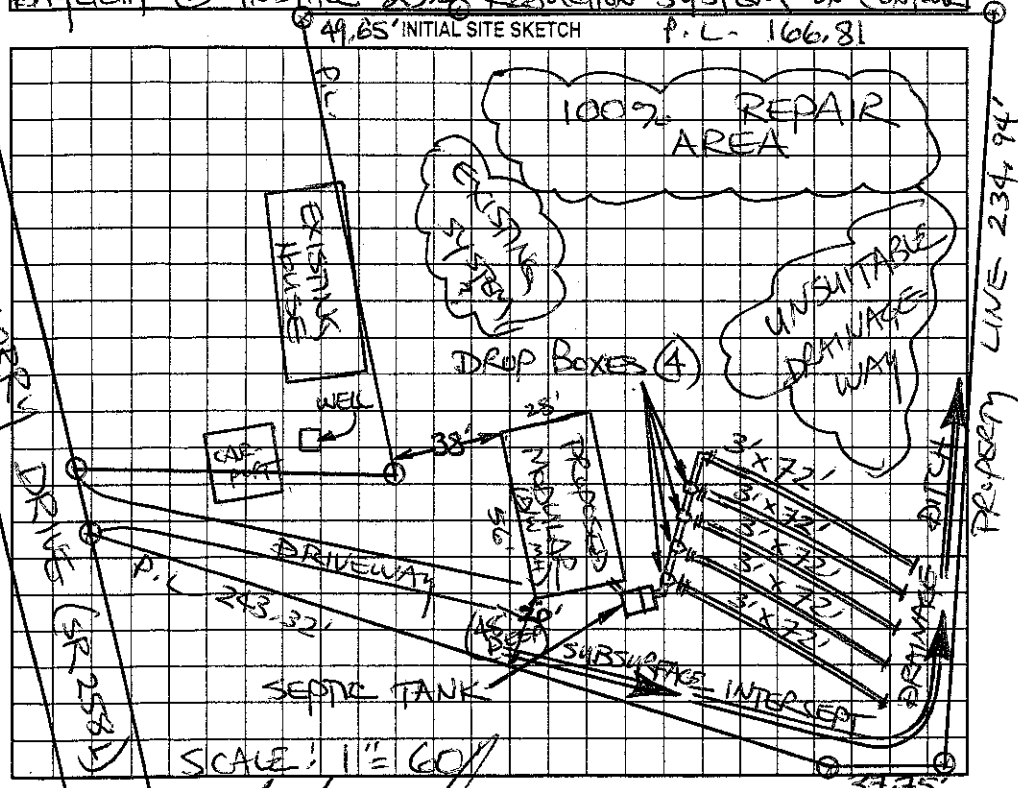

AS BUILT SKETCH

SYSTEM INSTALLED ACCORDING TO INITIAL SITE SKETCH

Permit can be suspended or revoked if any false information is supplied toward securing the permit/any unauthorized changes are made to the site/any unauthorized changes are made in the installation of the system. Improvement Permit with plat valid without expiration. ~~Improvement Permit with site~~ plan valid for sixty months. Authorization to Construct is valid for a period equal to that of Improvement Permit – not to exceed sixty months.

Signed: date

Improvement Permit by: STEVE HEDRICK date 10-3-03

Authorization to Construct by: STEVE HEDRICK date 10-3-03

Installed by: TUCKERS GRADING

Operation Permit by: STEVE HEDRICK date 12-15-03

Existing System Inspection by: date

HEALTH DEPT. COPY: WHITE OWNER COPY (FINAL): YELLOW OWNER COPY (INITIAL): PINK