IREDELL COUNTY HEALTH DEPARTMENT

STATESVILLE 704-878-5305 MOORESVILLE 704-664-5281

IMPROVEMENT PERMIT / CERTIFICATE OF COMPLETION / OPERATION PERMIT / EXISTING SYSTEM INSPECTION

PROPERTY DESCRIPTION NO. 70317 DATE 11-13-97 TAX MAP NO. 4754596 9 Watershed: ☐ Yes ☐ No

OWNER OR CONTRACTOR Brett Brooks PHONE: Business ~~828~~ Home 827-5296

ADDRESS 514 Woodlawn Ave Belmont N.C.

LOCATION East Broad St TR Greenbriar Cross 4th Creek 1/4mi left back

SUBDIVISION 4thcreekcrossing BLOCK / SECTION LOT 12 LOT AREA 4.3 acres SITE CLASS. V3 DESIGN FLOW 480 L.T.A.R. .33 BTS RS

Septic Tank: 1000 Gallons; STB 1012 Date 11-19-97

Pump Tank: Gallons; PT Date

Pump Make: Model Serial No.

Nitrification Field: No Fields 1 Square Feet 1440 Linear Feet 480

No Lines 4 Trench Width 36 Max Trench Bottom Depth 36" Gravel Depth 12"

☑ New System ☐ Repair System Type: I, II, III, IV, V, VI

System Description: conv. Gravity

Repair System Description: " "

Maintenance Agreement Required: ☐ Yes ☑ No

☐ House/Mod. Home ☑ Mobile Home ☐ Business ☐ Other

No. Bedrooms 3 No. Bathrooms 2 No. Employees

Water Supply: ☐ Individual ☐ Community ☑ Public


☐ Slab ☑ Crawl Space ☐ Basement w/plumbing ☐ Basement wo/plumbing

Comments:


Comments:

Installed as shown

INITIAL SITE SKETCH

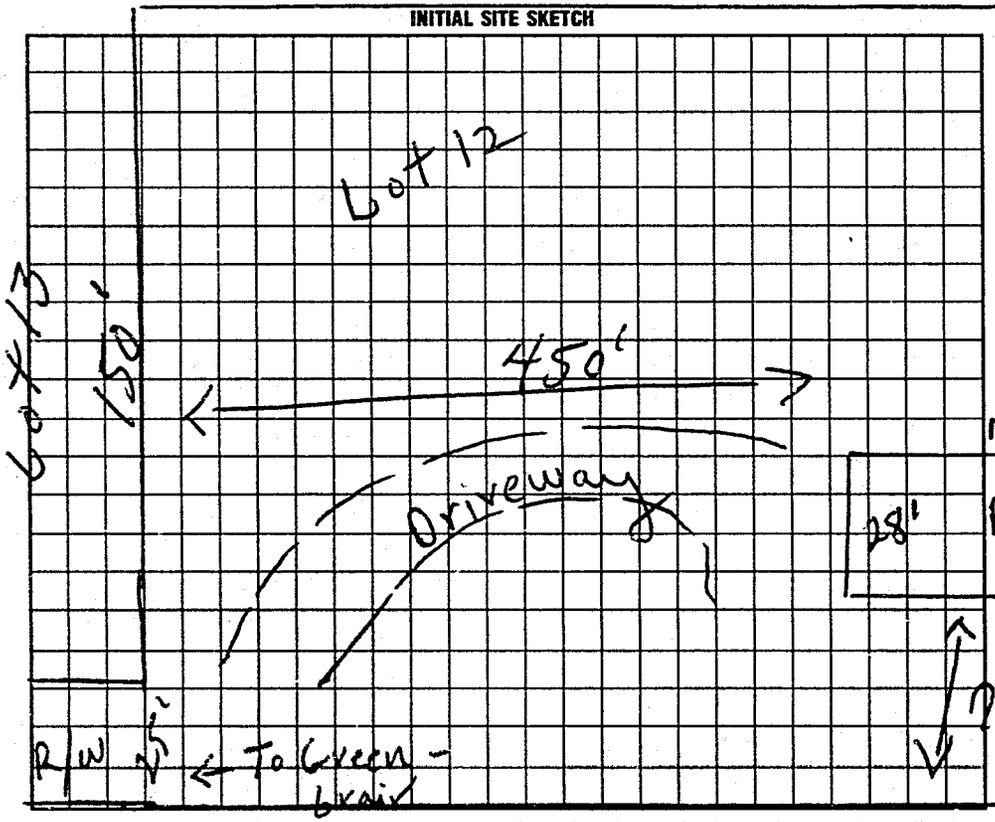

AS BUILT SKETCH

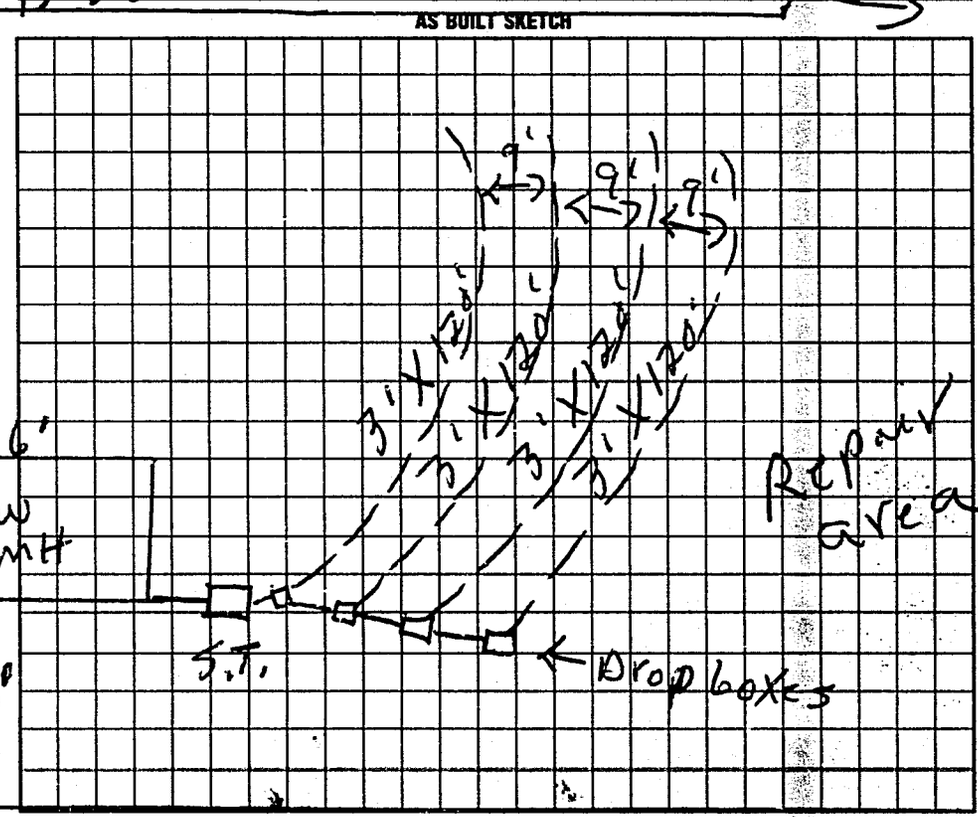

I understand that this permit can be suspended or revoked if any false information is supplied toward securing the permit/any unauthorized changes are made to the site/any unauthorized changes are made in the installation of the system. Improvement Permit is valid for 60 months from date of issuance.

Signed: X Russell Silver

Installed by: A-1 Backhoe

Improvement Permit by: R.C. Moore date 11-13-97

Certificate of Completion by: date

Authorization ~~Existing System Inspection~~ by: R.C. Moore date 11-13-97

Operation Permit by: Mark C. Otts date 3-3-98

HEALTH DEPT. COPY: WHITE INSPECTION COPY (FINAL): GREEN OWNER COPY (FINAL): YELLOW INSPECTION COPY (INITIAL): PINK OWNER COPY (INITIAL): GOLD

to Const. Authorization to const Expires 60 mos from issue

9 8 0 0