IREDELL COUNTY HEALTH DEPARTMENT

Statesville Phone TR 3-7271 Mooresville Phone NO 3-1271

PERMIT TO INSTALL SEPTIC TANK

Permit NO. _____ Permit Date Aug. 23 1963

Owner E K Seaborn Const. Co. Address Greenbrier Rd.

Installed By C Hoke Address _____

Location of Property out Broad to Greenbrier Site 1st


left to left on Corner. Fridley & Greenbrier.

| Tank | | Capacity | | Length of Lines | | Fixtures | |
|---|---|---|---|---|---|---|---|
| Block | ( ) | 800 | ( ) | 150' | ( ) | No. of Baths | (2) |
| Precast | (✓) | 900 | ( ) | 175' | ( ) | Dishwasher | ( ) |
| | | 1000 | (✓) | 200' | ( ) | Garbage Grdr. | ( ) |
| | | 1100 | ( ) | 225' | (✓) | Auto-Washer | (✓) |
| | | 1200 | ( ) | 250' | ( ) | Other | _____ |
| | | Other | _____ | Other | _____ | | |

NOTIFY HEALTH DEPARTMENT AT LEAST EIGHT HOURS BEFORE TANK IS TO BE INSPECTED.

Final Inspection 8-23 1963 Approved (✓) Disapproved ( )

Remarks Well 100' Owner

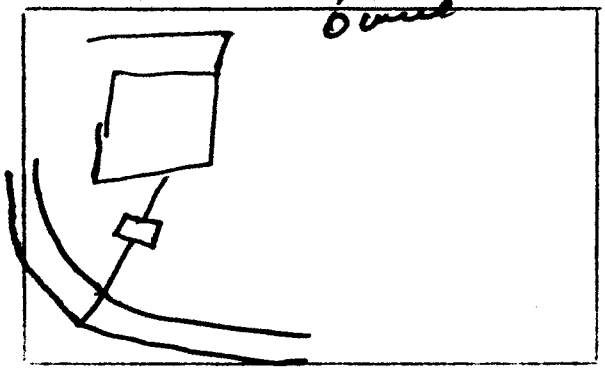

Sketch of Installation

Sanitarian