IREDELL COUNTY HEALTH DEPARTMENT

Statesville Phone TR 3-7271 Mooresville Phone NO 3-1271

PERMIT TO INSTALL SEPTIC TANK

Permit NO. _____ Permit Date Sept. 5 1968

Owner George Makepeace Address Statesville

Installed By Roy Lentz Address Statesville

Location of Property East Bend to Davie Rivers Rd


Second Rd to Right No. 2417 Third House Left

| Tank | | Capacity | | Length of Lines | | Fixtures | |
|---|---|---|---|---|---|---|---|
| Block | ( ) | 800 | ( ) | 150' | ( ) | No. of Baths | ( ) |
| Precast | ( 4 ) | 900 | ( ) | 175' | ( ) | Dishwasher | ( ) |
| | | 1000 | ( 4 ) | 200' | ( ) | Garbage Grdr. | ( ) |
| | | 1100 | ( ) | 225' | ( 4 ) | Auto-Washer | ( ) |
| | | 1200 | ( ) | 250' | ( ) | Other _____ | |
| | | Other _____ | | Other _____ | | | |

NOTIFY HEALTH DEPARTMENT AT LEAST EIGHT HOURS BEFORE TANK IS TO BE INSPECTED.

Final Inspection _____ 19___ Approved ( ) Disapproved ( )

Remarks _____

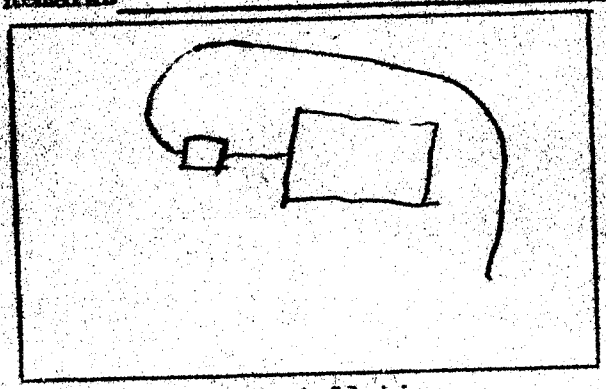

Sketch of Installation

Water on the

Sanitarian