Statesville Phone TR 3-7271

IREDELL COUNTY HEALTH DEPARTMENT

Mooresville Phone No. 664-5281

Permit No. 189 PERMIT TO INSTALL SEPTIC TANK

Owner Bldr. Roby Houston Permit Date 10-9 1972

Installed By LACKEY Bros Address Statesville, NC.


Location of Property EAST Broad St. EXT, Turn Right on Rd # 2415 before Greenbrier Rd. 4th House on LEFT.

Tank		Capacity		Length of Lines		Fixtures	
Block	( )	1000	( )	225'	( )	No. of Baths	(2½
Precast	(✓)	1250	(✓)	250'	( )	Dishwasher	(1)
		1500	( )	Other	( )	Garbage Grdr.	(1)
		Other		Other 256		Other	

NOTIFY HEALTH DEPARTMENT AT LEAST EIGHT HOURS BEFORE TANK IS TO BE INSPECTED.

Final Inspection 10-9 1972 Approved (✓) Disapprcved ( )

Remarks IREDELL WATER Corp.

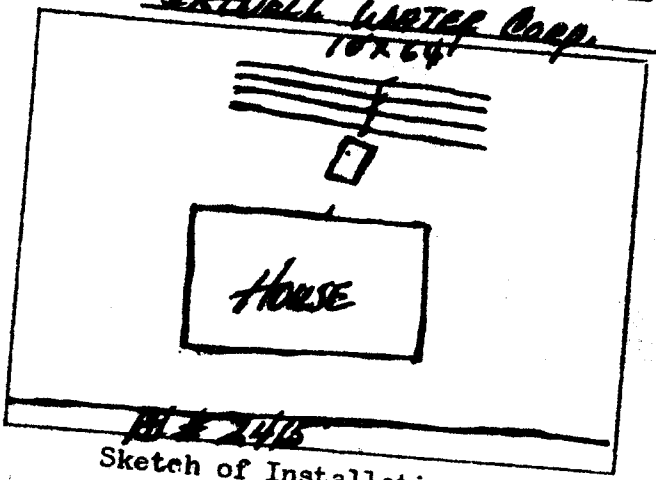

Sketch of Installation

Sanitarian