IREDELL COUNTY HEALTH DEPARTMENT

Statesville Phone TR 3-7271 Mooresville Phone NO 3-1271

PERMIT TO INSTALL SEPTIC TANK

Permit NO. Hoover Builde Permit Date May 10 1965

Owner Town & County Realty Co. Address % Realty Co.

Installed By C Hobe Address RJ


Location of Property Boardview - Green Bank Rd & Findley Rd

Tank		Capacity		Length of Lines		Fixtures	
Block	( )	800	( )	150'	( )	No. of Baths	(2)
Precast	(—)	900	( )	175'	( )	Dishwasher	( )
		1000	(—)	200'	( )	Garbage Grdr.	( )
		1100	( )	225'	(—)	Auto-Washer	(—)
		1200	( )	250'	( )	Other	
		Other		Other			

NOTIFY HEALTH DEPARTMENT AT LEAST EIGHT HOURS BEFORE TANK IS TO BE INSPECTED.

Final Inspection _____ 19___ Approved ( ) Disapproved ( )

Remarks well 75'

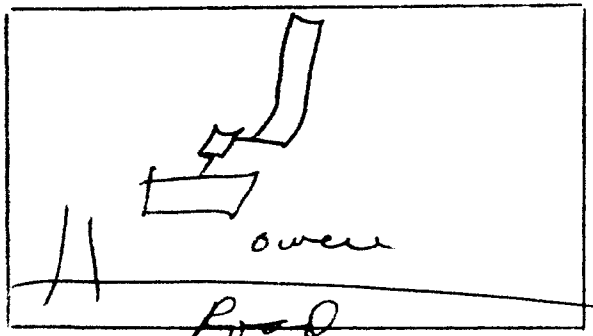

Sketch of Installation

Sanitarian