IREDELL COUNTY HEALTH DEPARTMENT

Statesville Phone TR 3-7271 Mooresville Phone NO 3-1271

PERMIT TO INSTALL SEPTIC TANK

Permit No. 142 Permit Date 6-27 1972

Owner Edgar Crawfill Address Statesville

Installed By Raymond Adams Address Hiddenite


Location of Property Exit on exit Broad extension to Green Brier Rd Turn Rt pass 1st paved Rd to Rt 2nd house on Rt

Tank		Capacity		Length of Lines		Fixtures	
Block	( )	1000	( )	225'	( )	No. of Baths	(2)
Precast	(✓)	1250	(✓)	250'	( )	Dishwasher	(✓)
		1500	( )	Other 255		Garbage Grdr.	(✓)
		Other				Other	

NOTIFY HEALTH DEPARTMENT AT LEAST EIGHT HOURS BEFORE TANK IS TO BE INSPECTED.

Final Inspection 19 Approved ( ) Disapproved ( )

Remarks PUBLIC water

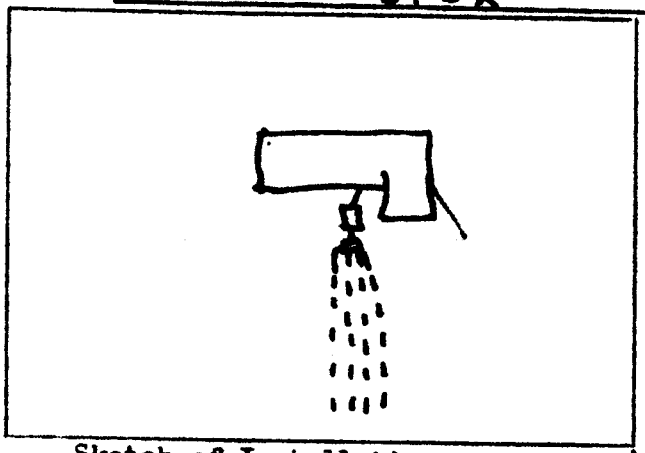

Sketch of Installation

Not checked.

Sanitarian