IREDELL COUNTY HEALTH DEPARTMENT

STATESVILLE 704-878-5305 MOORESVILLE 704-664-5281

IMPROVEMENT PERMIT / AUTHORIZATION TO CONSTRUCT / OPERATION PERMIT / EXISTING SYSTEM INSPECTION

PERMIT# 095584 PIN# 4754 83 2714 DATE 6-21-01

OWNER OR CONTRACTOR MURIEL TURNER PHONE: Business _____ Home 704-878-6945

ADDRESS 483 BUFFALO SHOALS RD, STATESVILLE, NC 28677

LOCATION HWY 64 E, (R) GREENBRIAR, (L) CORRY ATCWD

SUBDIVISION _____ BLOCK / SECTION _____ LOT _____ LOT AREA 1.47 SITE CLASS PS DESIGN FLOW 360 L.T.A.R. .3

Septic Tank: 1000 Gallons, STB 1012 Date 4-7-01
Pump Tank: _____ Gallons, PT _____ Date _____
Pump Make: _____ Model _____ Serial No. _____
Nitrification Field: No Fields 4 Square Feet EQ2120 Linear Feet 200
No Lines 6 Trench Width 24" Max Trench Bottom Depth 36"

X New System ☐ Repair System Type: I. II. (III) IV. V. VI
System Description: GRAV PANEL
Repair System Description: LP PANEL
Maintenance Agreement Required: ☐ Yes X No
Gravel Depth N/A ☐ Slab X Crawl Space ☐ Basement w/plumbing ☐ Basement wo/plumbing


☐ House/Mod. Home No. Bedrooms 3
X Mobile Home DW No. Bathrooms 2
☐ Business No. Employees ____
☐ Other _____

Water Supply: X Individual ☐ Public ☐ Community
WELL


Comments/Conditions: ① INSTALL LINES ON CONTOUR ② MAINTAIN SETBACKS ③ USE FLOW DIVIDER TEE & 2 DISTRIBUTION BOXES WITH SPEED LEVELERS ④ USE 8 PANELS IN EACH DITCH

Comments/Conditions: ⑤ STAY 5' + OFF THE FILL AREA POLYLOK FILTER INSTALLED AS SHOWN

INITIAL SITE SKETCH 1"=40'

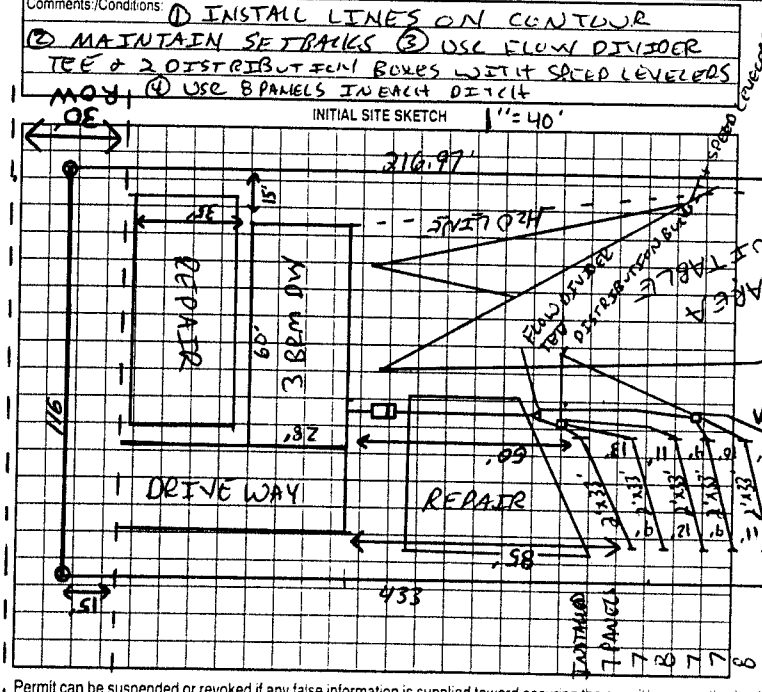

AS BUILT SKETCH

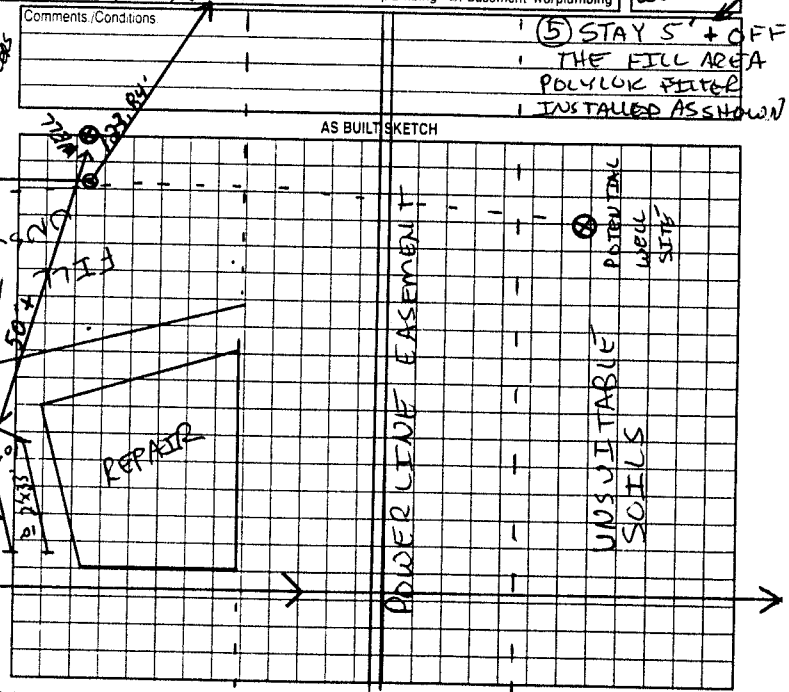

Permit can be suspended or revoked if any false information is supplied toward securing the permit/any unauthorized changes are made to the site/any unauthorized changes are made in the installation of the system. Improvement Permit with plat valid without expiration. Improvement Permit with site plan valid for sixty months. Authorization to Construct is valid for a period equal to that of Improvement Permit – not to exceed sixty months.

Signed: Dennis Dalton date _____

Improvement Permit by: Jim Cook REHS date 6-21-01

Authorization to Construct by: Jim Cook REHS date 6-21-01

Installed by: A-1 BACKHOE

Operation Permit by: Jim Cook RS date 8-8-01

Existing System Inspection by: _____ date _____

HEALTH DEPT COPY: WHITE OWNER COPY (FINAL): YELLOW OWNER COPY (INITIAL): PINK