IREDELL COUNTY HEALTH DEPARTMENT

STATESVILLE 704-878-5305 MOORESVILLE 704-664-5281

IMPROVEMENT PERMIT / CERTIFICATE OF COMPLETION / OPERATION PERMIT / EXISTING SYSTEM INSPECTION

PROPERTY DESCRIPTION NO. 20221 DATE 3-2-95 TAX MAP NO. Watershed: ☐ Yes ☐ No

OWNER OR CONTRACTOR Iredell County Animal Shelter PHONE: Business Home

ADDRESS Twin oaks Rd

LOCATION 64 E TR Greenbrair Tl Twincaks Rd 1/2 mi left (Revised Permit)

SUBDIVISION BLOCK / SECTION LOT LOT AREA SITE CLASS. PS DESIGN FLOW 600gal/600 T.A.R. .25

Septic Tank: 1500 Gallons; STB Date

Pump Tank: 1500 Gallons; PT Date

Pump Make: Model Serial No.

Nitrification Field: No Fields 1 Square Feet 1800 Linear Feet 600

No Lines 6 Trench Width 36" Max Trench Bottom Depth 36" Gravel Depth 12"

☐ New System ☑ Repair System Type: I, II, III, IV, V, VI

System Description:

Repair System Description: Pump To Infiltrator lines

Maintenance Agreement Required: ☐ Yes ☐ No

☐ House/Mod. Home No. Bedrooms

☐ Mobile Home No. Bathrooms


☐ Business No. Employees

☐ Other


☑ Slab ☐ Crawl Space ☐ Basement w/plumbing ☐ Basement wo/plumbing

Water Supply: ☑ Individual ☐ Community ☐ Public


Comments: Use Infiltrator Panels + Screened Sand around Panels + In bents

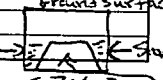


Comments: Place Sand In These areas

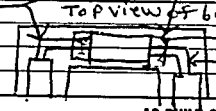

INITIAL SITE SKETCH

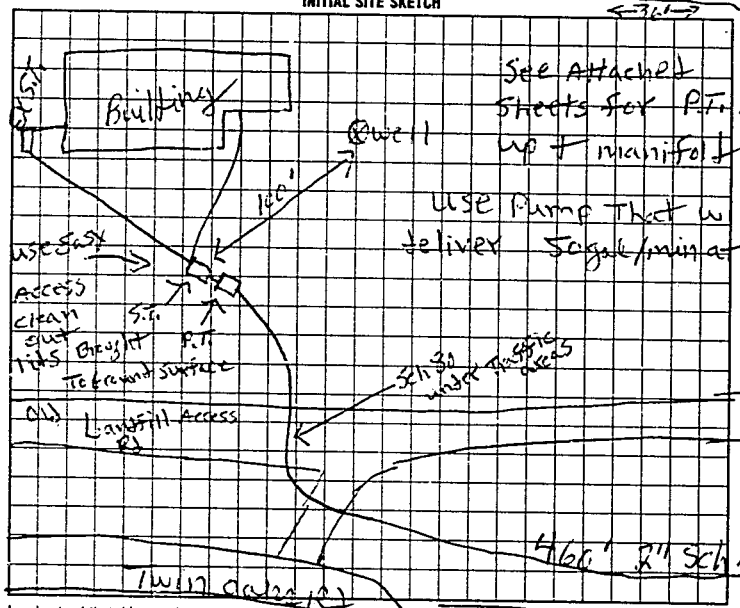

AS BUILT SKETCH

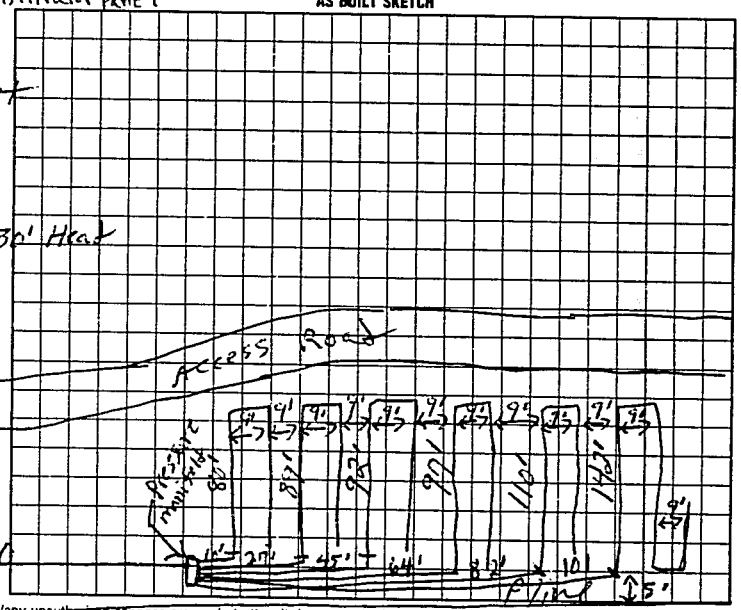

I understand that this permit can be suspended or revoked if any false information is supplied toward securing the permit/any unauthorized changes are made to the site/any unauthorized changes are made in the installation of the system. Improvement Permit is valid for 60 months from date of issuance.

Signed:

Improvement Permit by: F. C. Moore date 3-2-95

Existing System Inspection by: date

Installed by:

Certificate of Completion by: Parlier Plumbing date

Operation Permit by: F. C. Moore date 9-7-95

HEALTH DEPT COPY: WHITE INSPECTION COPY (FINAL): GREEN OWNER COPY (FINAL): YELLOW INSPECTION COPY (INITIAL): PINK OWNER COPY (INITIAL): GOLD

062000