IREDELL COUNTY HEALTH DEPARTMENT

Statesville Phone TR 3-7271 Mooresville Phone NO 3-1271

PERMIT TO INSTALL SEPTIC TANK

Permit No. 181 Permit Date 4-5 1972

Owner L. A. PARKS, JR. Address STATESVILLE, N.C.

Installed By HARLEE LACKEY Address STONY POINT, N.C.

Location of Property SHANNON ACRES - (COUNTRY CLUB)


S. AUGUSTA DR. (ON DIRT STREET)

Tank		Capacity		Length of Lines		Fixtures	
Block	( )	1000	( )	225'	( )	No. of Baths	(5)
Precast	(✓)	1250	(✓)	250'	( )	Dishwasher	(/)
		1500	( )	Other 300		Garbage Grdr.	(/)
		Other		900 SQ. FT.		Other	

NOTIFY HEALTH DEPARTMENT AT LEAST EIGHT HOURS BEFORE TANK IS TO BE INSPECTED.

Final Inspection 4-5 1972 Approved (✓) Disapproved ( )

Remarks

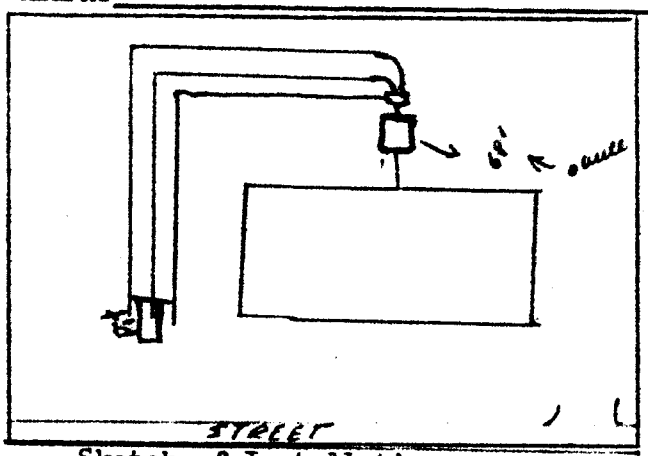

Sketch of Installation

Glenn Taylor Jr.

Sanitarian