IREDELL COUNTY HEALTH DEPARTMENT

Statesville Phone TR 3-7271 Mooresville Phone NO 3-1271

PERMIT TO INSTALL SEPTIC TANK

Permit NO. C.B. Gannt Bldr. Permit Date July 24 19 68

Owner Mr. Jim Seays. Address % Benit mill city

Installed By C Hoke Address R7.


Location of Property Shannon Acres. - 1st street off E. Bud St. - 2nd st. to R. - then X Rd. on Left 1 blk.

Tank		Capacity		Length of Lines		Fixtures	
Block	( )	1000	( )	225'	( )	No. of Baths	(3)
Precast	(✓)	1250	(✓)	250'	( )	Dishwasher	(-)
Wash		1500	( )	Other 675 Sq ft.		Garbage Grdr.	(-)
		Other				Other	

NOTIFY HEALTH DEPARTMENT AT LEAST EIGHT HOURS BEFORE TANK IS TO BE INSPECTED.

Final Inspection -9 Approved ( ) Disapproved ( )

Remarks impossible to grow wooded - near branch. Clay and high water table - sewer pumped to lines as tank lower than field. extra tuf lite used on lateral tile. 8" - 2" over.

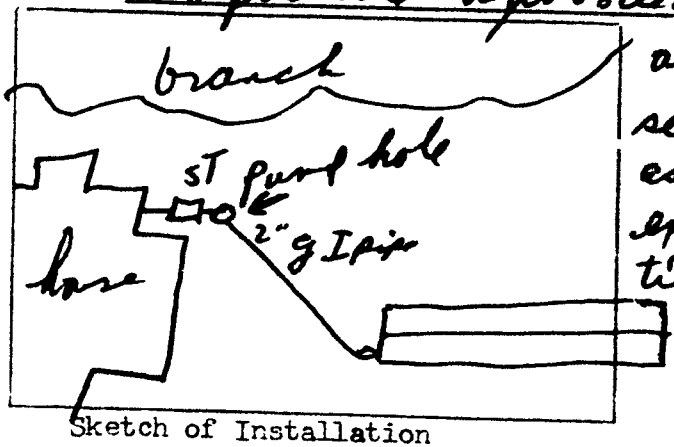

Sketch of Installation

over.

Sanitarian