ICHD - ENVIRONMENTAL HEALTH DIVISION

Statesville Office (704) 878-5305 | Mooresville Office (704) 660-3625 | PERMIT # AP-313885

SEPTIC: IMPROVEMENT PERMIT / AUTHORIZATION TO CONSTRUCT / OPERATION PERMIT / EXISTING SYSTEM

✓ PIN # 4755 -50 -5619

APPLICANT/OWNER: KEITH SHARPE SENIOR | APPLICANT ADDRESS: 208 HERITAGE CIRCLE, STATESVILLE, N.C. 28625

SITE ADDRESS: 208 HERITAGE CIRCLE, STATESVILLE, N.C. 28625 | PHONE: 704-500-5495 | ALT. PHONE 704-231-6852

SITE DIRECTIONS: (S) ON 77, (L) ON EAST BROAD, (L) ON EAST ELEMENTARY, (R) ON EAST BROOK, (L) ON HERITAGE, LOT ON (R)

SAP CONTROLLED: ☐ YES ☐ NO EXT


SUBDIVISION: ✓ EASTBROOK | SECTION: — | LOT # 15 | LOT AREA: 0.5 AC | DESIGN FLOW: EXT | L.T.A.R.: EXT

Septic Tank	1000 (gal)	STB 794	Date 1/6/2021	☐ New System	☑ Repair	☐ Expansion	System Type: I (II) III IV V VI	☑ Residence	No. Bedrooms EXT
Pump Tank	— (gal)	PT —	Date —	System Description:		EXT		☐ Business	No. Persons EXT
Pump Make	—	Model —	Serial # —	Repair System Description:		TANK REPLACEMENT		☐ Other	No. Employees —
# Nitrification Fields	EXT	# Lines EXT	Linear Ft: EXT	Maintenance Agreement Required:	☐ YES	☑ NO		☐ Slab	☑ Crawl Space
Trench Width	EXT	Trench Bottom Depth(Low side)	EXT	Gravel Depth	EXT	☑ GRAVITY	☐ PRESSURE	☐ Basement w/plumbing	☐ Basement w/o plumbing

Water Supply: ☐ Private ☑ Public ☐ Community

Comments / Conditions: PUMP, CRUSH, AND FILL EXISTING TANK, INSPECT AND REPLACE DISTRIBUTION DEVICE, EXISTING GRAVEL BED APPEARED TO BE FUCTIONING AT TIME OF INSPECTION


INITIAL SITE SKETCH

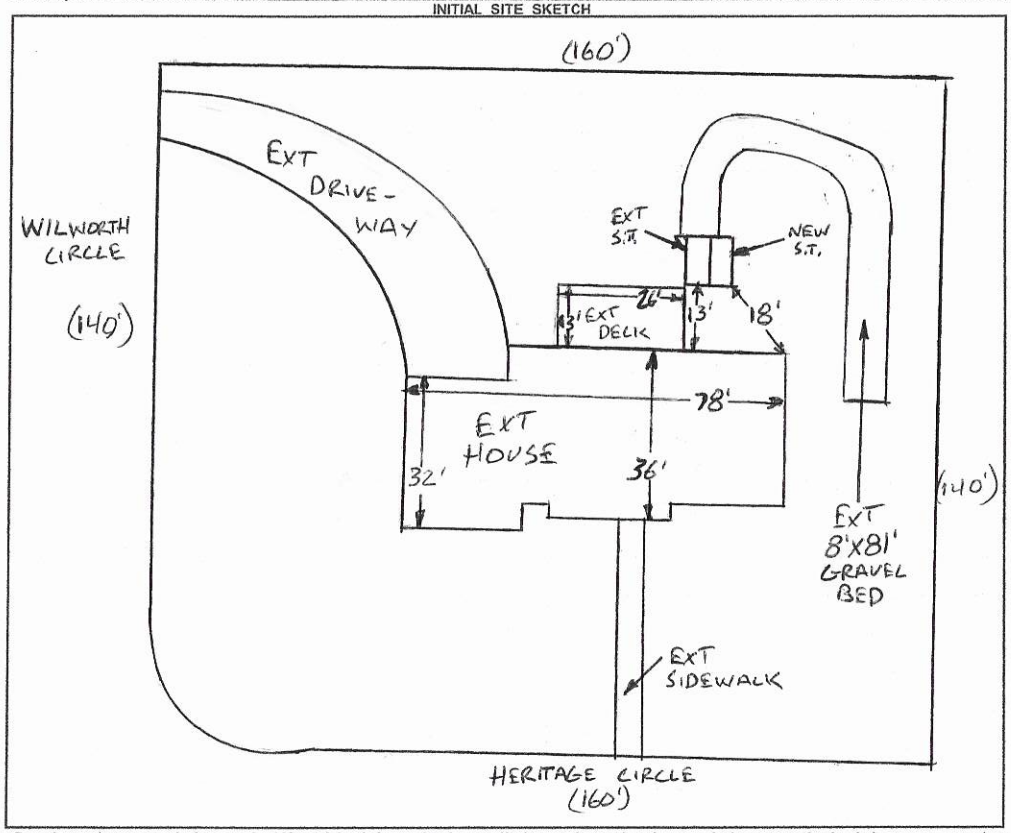

AS BUILT SKETCH

FOR SEPTIC FINAL INSPECTION CALL: 704-664-3703 between 8am-9am the day the inspection is needed. Be sure to speak with an inspector to confirm your time.

1 IN = 40 FT
S.T. = SEPTIC TANK
EXT = EXISTING

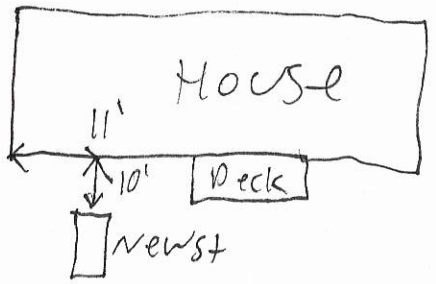

Permit can be suspended or revoked if any false information is supplied toward securing the permit / any unauthorized changes are made to the site / any unauthorized changes are made in the installation of the system. **CONTACT A LOCATOR SERVICE PRIOR TO ANY EXCAVATION**

☐ **IMPROVEMENT PERMIT** *with plat valid without expiration.* ☑ **IMPROVEMENT PERMIT** *with site plan valid for 60 mos.* ☑ **AUTHORIZATION TO CONSTRUCT** *valid for period equal to IMPROVEMENT PERMIT--not to exceed 60 mo.*

Owner / Applicant Signature: Keith Sharpe | Date: 2-11-21 | Installed by: ADON

IMPROVEMENT PERMIT by: Bryant C. White | Date: 2-11-2021 | OPERATION PERMIT by: Patrick J Bolt III | Date: 3/12/2021

AUTHORIZATION TO CONSTRUCT by: Bryant C. White | Date: 2-11-2021 | Existing System Inspected by: | Date:

FOR SEPTIC FINAL INSPECTION: CALL 704-664-3703 between 8am-9am the day the inspection is needed.

AP 313885 Rec'd 1/5/2021

APPLICATION MUST BE FILLED OUT COMPLETELY & BE LEGIBLE
OR IT WILL NOT BE PROCESSED 4755-50-5619 @

Iredell County Health Department – Environmental Health Division

PAGE 1: *APPLICATION FORM*

Application For: ( ) New Well Permit ( ) Well Repair Permit ( ) Well Abandonment
( ) Septic Improvement Permit ( ) Authorization to Construct ( ) Existing System Inspection (✓) Septic System Repair

THE ABOVE PERMIT DOCUMENTS WILL BECOME INVALID IF INFORMATION PROVIDED ON THIS APPLICATION IS FALSIFIED OR CHANGED, OR IF THE SITE IS ALTERED. THE IMPROVEMENT PERMIT IS VALID FOR EITHER 60 MONTHS OR WITHOUT EXPIRATION DEPENDING UPON DOCUMENTATION SUBMITTED. APPLICATION WITH SITE PLAN 60 MONTHS, APPLICATION WITH COMPLETE, SCALED PLAT WITHOUT EXPIRATION. SEE 15A NCAC 18A .1937(f) FOR DETAILS.

Page 2: *Site Plan Worksheet* form MUST accompany this application

The following optional attachments may also be submitted: ( ) Survey Plat, scaled no more than 1 inch = 60 feet
Place an (X) beside whichever is submitted if applicable ( ) Custom Site Plan, scaled no more than 1 inch = 60 feet

Applicant Information: (PRINT CLEARLY)

Applicant Name: Keith Sharpe Sr. Address: 208 Heritage Rd. Zip: 28625
Applicant Email: keithsharpe.130@yahoo.com Phone: 704-500-5495 Alt. Phone: 704-231-6852
Owner Name: Keith Shaepe SR. Address: Same as above Zip: _____
Owner Email: _____ Phone: _____ Alt. Phone: _____

Property Information:

Street Address: 208 Heritage ~~Rd.~~ Circle, Statesville NC 28625
Subdivision Name: Eastbrook Section/Phase: _____ Lot Number: 15
Driving Directions: I-77 exit 50, E Broad St, E Elementary Rd, East Brook Ln, Heritage Rd.

Site Development Information: *(check or complete ALL that apply*

( ) New Single Family Residence
( ) New Multi-Family Residence
( ) Accessory Building
( ) Bedroom(s) Addition
(✓) Repair to failing septic system ___ Tank ___ Drain lines Describe Problem: Collapsed Septic System
Maximum Number of Bedrooms: 3
Maximum Number of Occupants: 3
( ) Swimming Pool
( ) Other Addition/Structure: _____
Non-Residential Site Development: Type of Business: _____
Square Footage of Building: _____ Max. Number of Employees: ____ Max. Number of Seats/Beds/Other: ____

CHECK FOUNDATION TYPE

(✓) Crawl Space Foundation
( ) Concrete Slab Foundation
( ) Basement with Plumbing
( ) Basement without Plumbing

Water Supply: ( ) Replacement Well – Reason: _____
( ) Multi-connection Well Number of Houses: _____ Number of Persons: _____

( ) New Well ( ) Existing Well ( ) Community Well ( ) City Water (✓) Other Public Water (City)

Desired Septic System Type: *(you may rank in order of preference)* Year existing system installed: 1973
( ) No Preference ( ) Alternative ( ) Conventional ( ) Innovative ( ) Modified Conventional ( ) Other: _____

Please answer the following to the best of your ability:

( ) Yes (✓) No Does the site contain any jurisdictional wetlands?
( ) Yes (✓) No Is any non-domestic sewage (i.e. industrial) to be generated?
( ) Yes (✓) No Is the site subject to approval by any other public agency?

I have read this application and certify that the information provided herein is true, complete, and correct. Authorized county and state officials are granted right of entry to conduct necessary inspections to determine compliance with applicable laws and rules. I understand that I am solely responsible for the proper identification and labeling of all property lines and corners and making the site accessible so that a complete site evaluation can be performed.


Signature: Keith Sharpe Sr. 12-29-20
Property owner or owner's legal representative signature (SIGNATURE REQUIRED) DATE

IREDELL COUNTY HEALTH DEPARTMENT

ENVIRONMENTAL HEALTH DIVISION

PAGE 2: *SITE PLAN WORKSHEET*

SEE THE "SAMPLE SITE PLAN" BELOW. *INCOMPLETE SITE PLANS WILL BE RETURNED TO YOU FOR COMPLETION AND MAY RESULT IN A DELAY IN THE ISSUANCE OF YOUR SEPTIC SYSTEM PERMIT!!!*

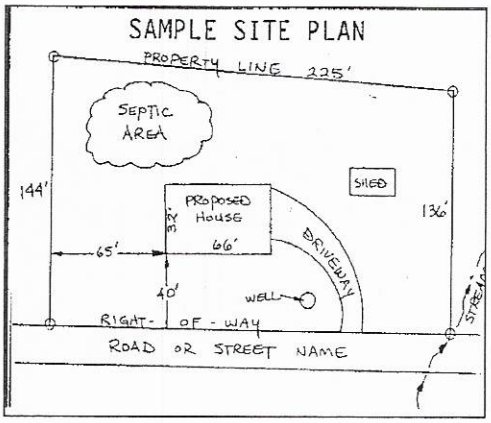

Place an (X) beside each item as you complete the site plan:


( ) Property Line measurements are clearly identified
( ) All proposed structures are indicated
( ) Front and side setbacks from property line
( ) Preferred driveway location and well location
( ) Area you prefer your septic system to be placed
( ) North arrow, or other sufficient indicator of direction

Circle N/A on the following if appropriate:

Location of septic systems and wells within 100' of your property	N/A
Location of easements and rights of ways on your property	N/A
Location of any designated wetlands on the property	N/A

USE THIS SPACE TO DRAW YOUR SITE PLAN

Show: proposed house or business footprint, wells, water lines, patios, pools and decks, and any other item that will occupy space on the site

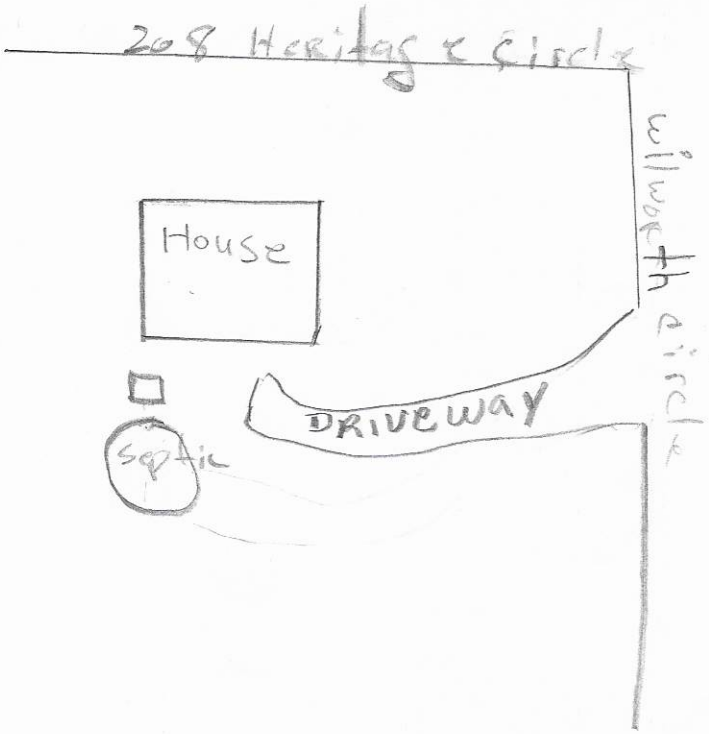

Signature: Kutt Sharpe Sr.
Property owner or owner's legal representative signature (SIGNATURE REQUIRED)

12-29-20
DATE

Statesville Phone TR 3-7271 Mooresville Phone NO 3-1271

PERMIT TO INSTALL SEPTIC TANK

Permit NO. 97 Permit Date 8-24 1972

Owner Kyle Const. Co. (Bldr. R.G. Dunn) Address EastView Acres Heritage Rd.

Installed By Raymond Adams Address Iredell, N.C.


Location of Property EASTVIEW ACRES. HERITAGE RD. LEFT. 2ND HOUSE ON RT.

Tank		Capacity		Length of Lines		Fixtures	
Block	( )	1000	( )	225'	( )	No. of Baths	( )
Precast	(✓)	1250	(✓)	250'	( )	Dishwasher	( )
		1500	( )	Other 255		Garbage Grdr.	( )
		Other				Other	

NOTIFY HEALTH DEPARTMENT AT LEAST EIGHT HOURS BEFORE TANK IS TO BE INSPECTED.

Final Inspection 8-24 1972 Approved (✓) Disapproved ( )

Remarks IREDELL WATER CORP.

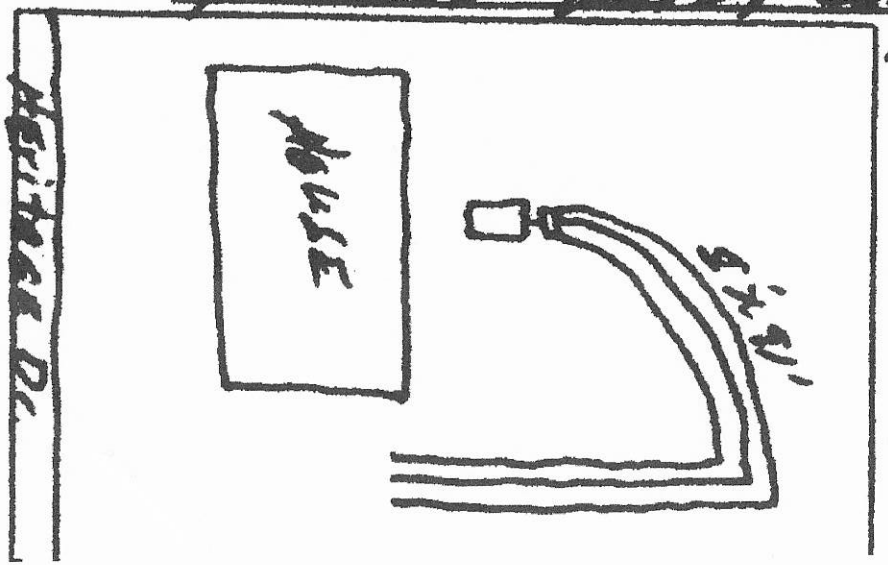

Public Health
Prevent. Promote. Protect.
Iredell County Health Department

IREDELL COUNTY DEPARTMENT OF ENVIRONMENTAL HEALTH

Public Health
Prevent. Promote. Protect.
Iredell County Health Department

DOCUMENTATION TO AUTHORIZE AN OWNER'S LEGAL REPRESENTATIVE

(Check and sign only ONE of the options below)

☑ **1. * APPLICANT AND OWNER ARE THE SAME. *** (*Sign here*) Keith Sharpe

Applications for permits require the "signature of the owner or owner's legal representative" (15A NCAC 18A .1937). If the owner does not sign the application himself or herself, they can submit any one of the following documents to designate their legal representative: *Power of Attorney; Real Estate Contract; Estate executor; Bankruptcy trustee; Court ordered guardianship*
In the absence of the above documentation, the property owner may provide the local health department with documentation that designates a legal representative. A property owner may:
Complete this form to document his or her legal representative, or provide his or her own form that contains the information in this form. If there are multiple property owners, then all property owners must sign the form that designates a legal representative.
By signing a form that designates a legal representative for purposes of 15A NCAC 18A .1937, the property owner authorizes that representative to act on their behalf in matters pertaining to the application and permitting process, including signing or receiving any application, document or permit. The owner retains full responsibility to meet all permit conditions specified by the local health department.

☐ **2.** I, _____, am the legal owner(s) of the property located at _____, identified as PIN (Parcel Identification Number) _____, located in Iredell County, North Carolina.

I do hereby authorize (**print legal representative/company name**) _____, _____, to act as an agent on my behalf in applying for/signing/obtaining any of the documents described below.

- Application for Improvement Permit (IP) / Authorization to Construct (AC)
- Improvement Permit (IP) / Authorization to Construct (AC)
- Application for soil-site evaluation (new/repair)
- Application/permit for private drinking water well/well abandonment
- Application for Compliance Inspection

I agree to abide by all decisions and/or conditions between the legal representative acting on my behalf and the Iredell County Department of Public Health, Environmental Health Division.

Keith Sharpe Sr. — Signature of Owner(s)

12-29-20 — Date

Mooresville - Environmental Health

Fax: 704-662-3239
610 E. Center Avenue, Mooresville, NC 28115

Statesville - Environmental Health
ronda.hart@co.iredell.nc.us
Fax: 704-871-3483
349 N. Center Street, Statesville, NC 28677