IREDELL COUNTY HEALTH DEPARTMENT

Statesville Phone TR 3-7271 Mooresville Phone No. 664-5281

PERMIT TO INSTALL SEPTIC TANK

Permit No. 627 Permit Date _____ 19___

Owner Stikeleather - Builder Address _____

Installed By Raymond Adams Address _____


Location of Property East Brook Sub-division off E. Broad St. House at end of 2nd Circle.

Tank		Capacity		Length of Lines		Fixtures	
Block	( )	1000	( )	225'	( )	No. of Baths	(3)
Precast	(✓)	1250	(✓)	250'	( )	Dishwasher	(1)
		1500	( )	Other 270'		Garbage Grdr.	(1)
		Other _____				Other _____	

NOTIFY HEALTH DEPARTMENT AT LEAST EIGHT HOURS BEFORE TANK IS TO BE INSPECTED.

Final Inspection 8-7-1953 Approved (✓) Disapproved ( )

Remarks Lines about 4 feet deep

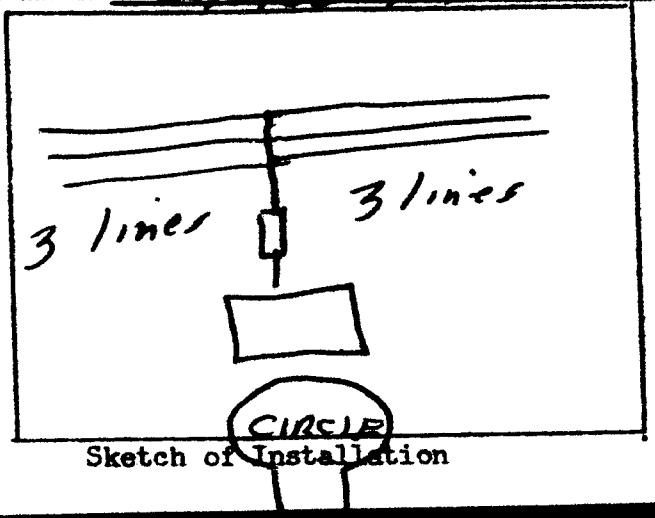

Sketch of Installation

C. S. Hall

Sanitarian