IREDELL COUNTY HEALTH DEPARTMENT

(SEPTIC TANK) IMPROVEMENTS PERMIT AND CERTIFICATE OF COMPLETION
(Ground Absorption Sewage Disposal System -- G. S. Chapter 130-Article 13C)

OWNER OR CONTRACTOR C+C Custom Homes DATE 5-10-88 PERMIT NO. _____

PHONE: Business _____ Home _____

LOCATION Fines creek Dr. Thru Neely Green circle 2nd lot on left S. R. No. _____

SUBDIVISION NAME _____ LOT NO. _____ SECTION OR BLOCK NO. _____


House (✓) Mobile Home ( ) Business ( ) Other _____

No. Bedrooms 3	No. Bathrooms 2½	Character & Porosity of Soil	Clayey
Garbage Disposal Unit	Yes (✓) No ( )	Percolation Rate	1
Auto. Dishwasher	Yes (✓) No ( )	Topography	2+6670
Auto. Wash. Machine	Yes (✓) No ( )	Depth to Water Table	10+
Site Suitable	Yes (✓) No ( )	Rock or other impervious formations	none

Lot Area 210'X141'

✓ Basement with Plumbing _____ Basement without Plumbing _____ No Basement

Plumbed Tounger Rvel Sewage lift pump

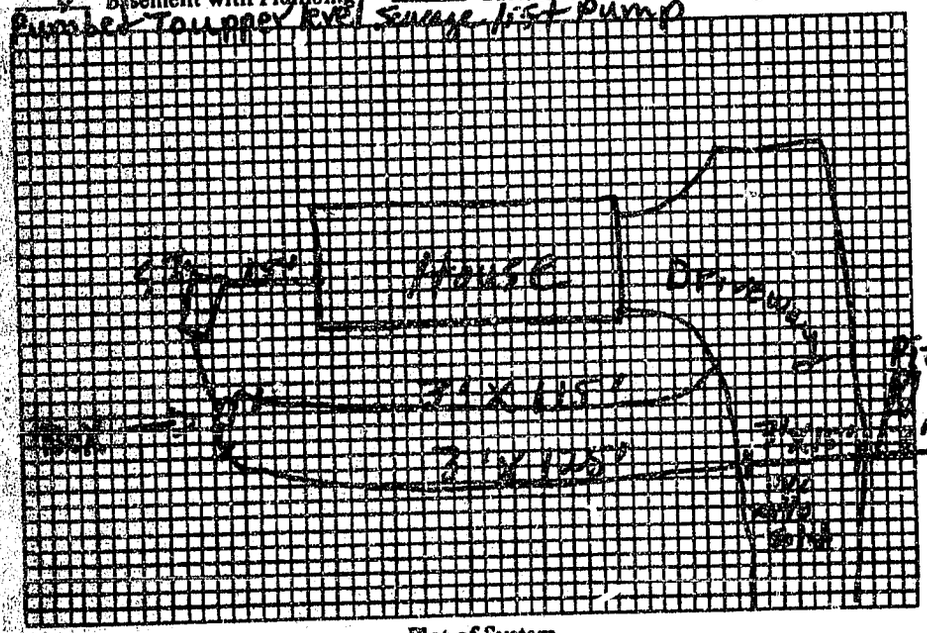

Plot of System

Size of Tank 1250 Gals.

Nitrification Field:
No. of Lines 2
Sq. Ft. 195 Linear Ft. 265
Depth of Stone in Lines 12

Water Supply: Individual ( )
Public (✓)
+ Pit Combo line

Installed by A-1 Backhoe

I understand and agree to install septic tank system as specified on this Improvements Permit.

Signed: _____

IMPROVEMENTS PERMIT BY R. C. moore

COMMENTS: lot was landscaped so that systems could not be installed as laid out but to notify lay-out

CERTIFICATE OF COMPLETION BY R. C. moore DATE 5-10-88

EXISTING SYSTEM CHECKED BY: _____ DATE _____

CONSTRUCTION MUST COMPLY WITH ALL OTHER APPLICABLE STATE AND LOCAL REGULATIONS.

Permit is VOID if any unauthorized changes are made in installation of system and/or if any false information is supplied in making Improvements Permit.

Health Dept. Copy: White Inspection Dept. Copy: Yellow Sanitarian's Copy: Pink Owner's Copy: Gold