IREDELL COUNTY HEALTH DEPARTMENT

Statesville Phone TR 3-7271 Mooresville Phone NO 3-1271

PERMIT TO INSTALL SEPTIC TANK

Permit NO. FC Grant Bldr Permit Date 12-20-1962

Owner HARland Adams Address East Brand st Ext

Installed By C Hoke Address RT.


Location of Property On left past steel Bridge 4th on left, Out E. BRAND EXT.

Tank		Capacity		Length of Lines		Fixtures	
Block	( )	800	( )	150'	( )	No. of Baths	(3)
Precast	(✓)	900	( )	175'	( )	Dishwasher	( )
		1000	(✓)	200'	( )	Garbage Grdr.	( )
		1100	( )	225'	(✓)	Auto-Washer	(✓)
Last		1200	( )	250'	( )	Other	
		Other		Other			

NOTIFY HEALTH DEPARTMENT AT LEAST EIGHT HOURS BEFORE TANK IS TO BE INSPECTED.

Final Inspection 12-20 1962 Approved (✓) Disapproved ( )

Remarks Well 50'

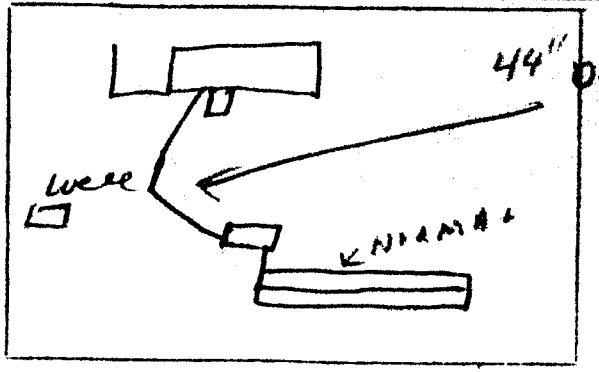

Sketch of Installation

R.A.

Sanitarian