IREDELL COUNTY HEALTH DEPARTMENT

(SEPTIC TANK) IMPROVEMENTS PERMIT AND CERTIFICATE OF COMPLETION
(Ground Absorption Sewage Disposal System – G. S. Chapter 130-Article 13C)

OWNER OR CONTRACTOR Karl Park DATE 7-20-83 PERMIT NO. _____

PHONE: Business _____ Home _____

LOCATION Neely Green Estates lot 49

S. R. No. _____

SUBDIVISION NAME _____ LOT NO. _____ SECTION OR BLOCK NO. _____


House (✓) Mobile Home ( ) Business ( ) Other _____

No. Bedrooms 3 No. Bathrooms 2 1/2

Garbage Disposal Unit	Yes (✓)	No ( )	Character & Porosity of Soil	Fine Sandy Clay loam
Auto. Dishwasher	Yes (✓)	No ( )	Percolation Rate	6 gal/sq' Hard
Auto. Wash. Machine	Yes (✓)	No ( )	Topography	2 to 6 %
Site Suitable	Yes (✓)	No ( )	Depth to Water Table	10' +
			Rock or other impervious formations	none

Lot Area 1 acre

_____ Basement with Plumbing _____ Basement without Plumbing _____ No Basement

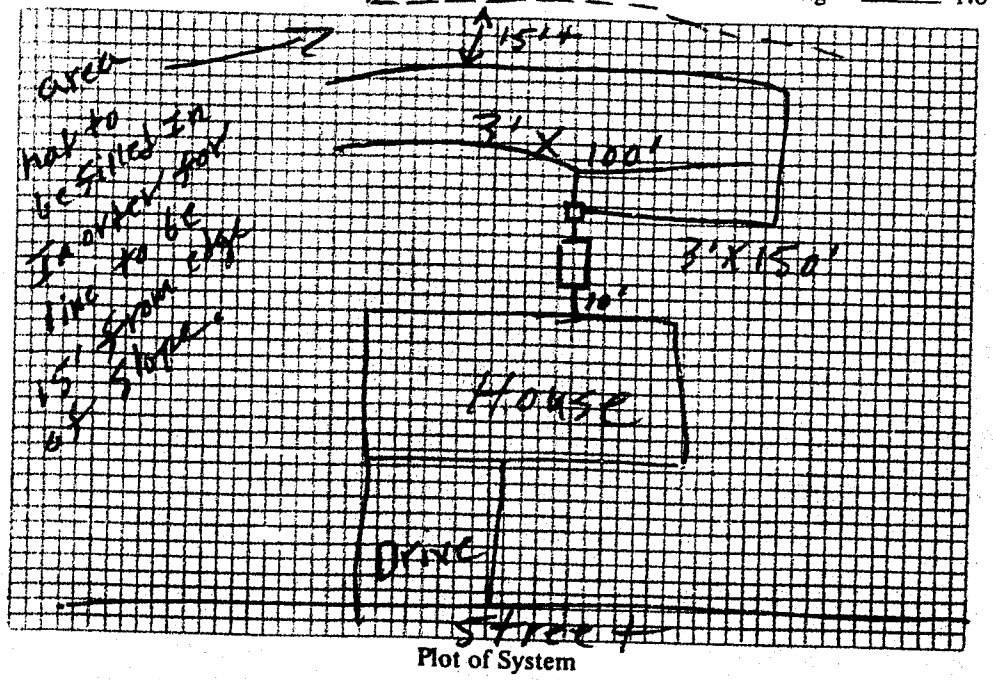

Plot of System

Size of Tank 1250 Gals.

Nitrification Field:
No. of Lines 2
Sq. Ft. 750 Linear Ft. 250
Depth of Stone in Lines 10"

Water Supply: Individual ( )
Public ( )

Installed by Donald Lackey

I understand and agree to install septic tank system as specified on this Improvements Permit.

Signed: _____

IMPROVEMENTS PERMIT BY L. C. Moore

COMMENTS: Drain Line was installed too close to the edge of slope area was filled In as indicated on drawing to move edge 15' away

CERTIFICATE OF COMPLETION BY L. C. Moore DATE 7-20-83

EXISTING SYSTEM CHECKED BY: _____ DATE _____

CONSTRUCTION MUST COMPLY WITH ALL OTHER APPLICABLE STATE AND LOCAL REGULATIONS.
Permit is VOID if any unauthorized changes are made in installation of system and/or if any false information is supplied in making Improvements Permit.

Health Dept. Copy: White Inspection Dept. Copy: Yellow Sanitarian's Copy: Pink Owner's Copy: Gold