IREDELL COUNTY HEALTH DEPARTMENT

Statesville Phone TR 3-7271 Mooresville Phone NO 3-1271

PERMIT TO INSTALL SEPTIC TANK

Permit NO Caffey Permit Date 46 - 6 6 19__

Owner J V Johnson Bldr. Address E. Broad Ext.

Installed By C Hoke Address R7.


Location of Property Past 4th Creek on E. Bd. Ext. on left. 3rd before next rd & left.

Tank		Capacity		Length of Lines		Fixtures	
Block	( )	800	( )	150'	( )	No. of Baths	(1½
Precast	(✓)	900	(✓)	175'	( )	Dishwasher	( )
		1000	( )	200'	( )	Garbage Grdr.	( )
Cast		1100	( )	225'	( )	Auto-Washer	(✓)
		1200	( )	250'	( )	Other	
		Other		Other 240.			

NOTIFY HEALTH DEPARTMENT AT LEAST EIGHT HOURS BEFORE TANK IS TO BE INSPECTED.

Final Inspection 46-6- 19__ Approved ( ) Disapproved ( )

Remarks Self Aspr - well 100'

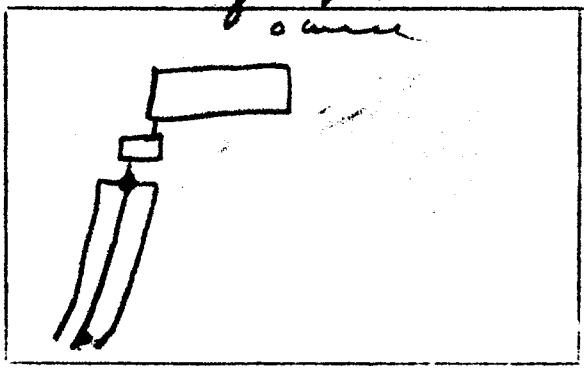

Sketch of Installation

R.A.J.

Sanitarian