IREDELL COUNTY HEALTH DEPARTMENT

Statesville Phone TR 3-7271 Mooresville Phone NO 3-1271

PERMIT TO INSTALL SEPTIC TANK

Permit NO. _____ 1 C Mont Beda Permit Date June 9 1961

Owner Geo. Weaver Address E. Brd. St.

Installed By C Hoke Address R 7


Location of Property last on right after cross 4th Creek on L, Brd St. before X RD.

Tank		Capacity		Length of Lines		Fixtures	
Block	( )	800	( )	150'	( )	No. of Baths	(2)
Precast	(✓)	900	( )	175'	( )	Dishwasher	( )
		1000	(✓)	200'	( )	Garbage Grdr.	( )
Wash		1100	( )	225'	(✓)	Auto-Washer	(✓)
		1200	( )	250'	( )	Other	
		Other		Other			

NOTIFY HEALTH DEPARTMENT AT LEAST EIGHT HOURS BEFORE TANK IS TO BE INSPECTED.

Final Inspection June 9 - 1961 Approved (✓) Disapproved ( )

Remarks Septic Tank

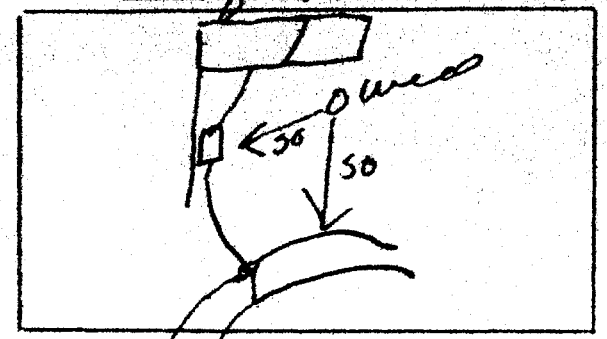

Sketch of Installation

R.T.

Sanitarian