IREDELL COUNTY HEALTH DEPARTMENT

Statesville Phone TR 3-7271 Mooresville Phone NO 3-1271

PERMIT TO INSTALL SEPTIC TANK

Permit No. 30 Permit Date 8-1 19 7x

Owner Bdr. S.B. Johnson Roby Houston Address Statesville, NC

Installed By LACKEY Bros Address Stony Point, NC


Location of Property ~~Hwy~~ E. EAST Broad St. Right on Rd. # 2415 - 3rd House on Left

Tank		Capacity		Length of Lines		Fixtures	
Block	( )	1000	( )	225'	( )	No. of Baths	(1½)
Precast	(✓)	1250	(✓)	250'	( )	Dishwasher	(✓)
		1500	( )	Other 255		Garbage Grdr.	(✓)
		Other				Other	

NOTIFY HEALTH DEPARTMENT AT LEAST EIGHT HOURS BEFORE TANK IS TO BE INSPECTED.

Final Inspection 19 Approved (✓) Disapproved ( )

Remarks Iredell Community Water Corp

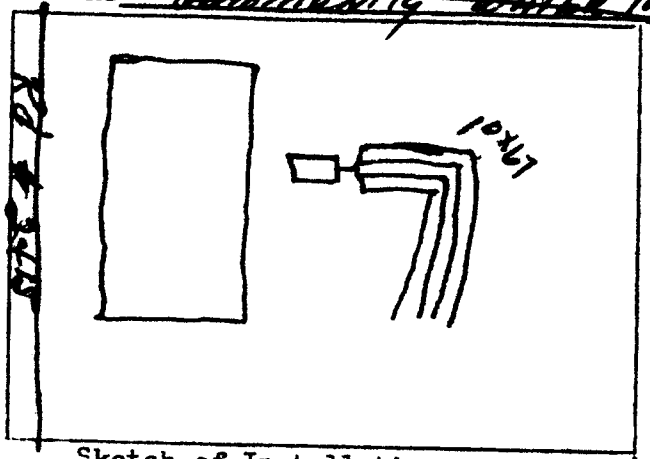

Sketch of Installation

Glenn T. Lee

Sanitarian