F.H.A form filled out Aug 13, 1959

IREDELL COUNTY HEALTH DEPARTMENT

Statesville Phone TR 3-7271 Mooresville Phone NO 3-1271

PERMIT TO INSTALL SEPTIC TANK

Permit NO. _____ Permit Date 8-11 1959

Owner Contractor Manny Gaston Address E. Board Ext.

Installed By C. Baker Address Rte 7. City


Location of Property Cross 4 Creek on Broad Ext. 1st pave rd to left. 1st brick on left.

| Tank | | Capacity | | Length of Lines | | Fixtures | |
|---|---|---|---|---|---|---|---|
| Block | ( ) | 800 | (✓) | 150' | ( ) | No. of Baths | ( ) |
| Precast | (✓) | 900 | ( ) | 175' | ( ) | Dishwasher | ( ) |
| Fiel | | 1000 | ( ) | 200' | (✓) | Garbage Grdr. | ( ) |
| | | 1100 | ( ) | 225' | ( ) | Auto-Washer | ( ) |
| | | 1200 | ( ) | 250' | ( ) | Other | |
| | | Other | | Other | | | |

NOTIFY HEALTH DEPARTMENT AT LEAST EIGHT HOURS BEFORE TANK IS TO BE INSPECTED.

Final Inspection 8/1 1959 Approved ( ) Disapproved ( )

Remarks Self apop Per TEH. - Washer on seperate line

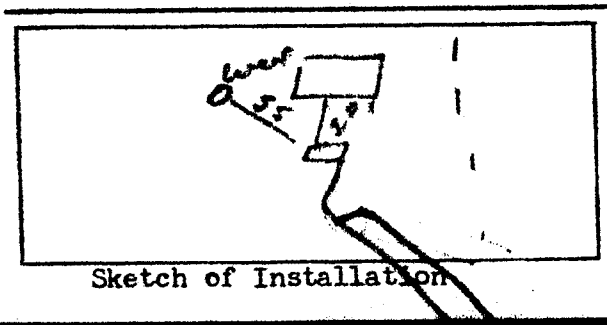


Sketch of Installation

R.G.L.

Sanitarian