2.5116 IREDELL COUNTY HEALTH DEPARTMENT Add 15'

Statesville Phone TR 3-7271 Mooresville Phone NO 3-1271

PERMIT TO INSTALL SEPTIC TANK

Permit NO._____ Permit Date May 29 1959

Owner Manny Baxter Address E. Bud. Est.

Installed By C Hoke Address R7


Location of Property Cross 4th Ave. I Paved to left. 1st new brick on left.

Tank		Capacity		Length of Lines		Fixtures	
Block	( )	800	(✓)	150'	(✓)	No. of Baths	(1)
Precast	(✓)	900	( )	175'	( )	Dishwasher	( )
		1000	( )	200'	( )	Garbage Grdr.	( )
		1100	( )	225'	( )	Auto-Washer	( )
		1200	( )	250'	( )	Other_____	
		Other_____		Other_____			

NOTIFY HEALTH DEPARTMENT AT LEAST EIGHT HOURS BEFORE TANK IS TO BE INSPECTED.

Final Inspection 5 29 1959 Approved (✓) Disapproved ( )

Remarks Washer on separate line Lot 4 acres

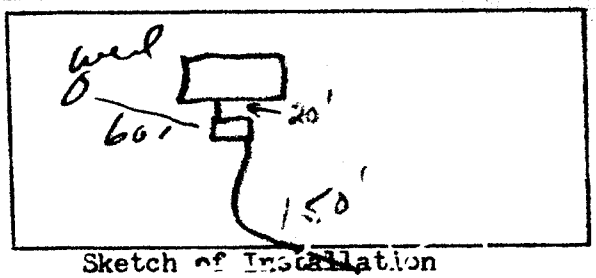

Sketch of Installation

Sanitarian