IREDELL COUNTY HEALTH DEPARTMENT

Statesville Phone TR 3-7271 Mooresville Phone NO 3-1271

PERMIT TO INSTALL SEPTIC TANK

Permit No. 167 Permit Date 2-18 1971

Owner COVENENT ARP CHURCH Address RT 1- STATESVILLE, NC

Installed By Smith Setzer & Sons Address Catawba, N.C.


Location of Property NORTHEAST CORNER - GREENBRIER RD. AND EAST BROAD ST. EXT.

Tank		Capacity		Length of Lines		Fixtures	
Block	( )	1000	( )	225'	( )	No. of Baths	(2)
Precast	(✓)	1250	( )	250'	( )	Dishwasher	( )
		1500	(✓)	Other 486		Garbage Grdr.	( )
		Other		1458 sq. ft.		Other	

NOTIFY HEALTH DEPARTMENT AT LEAST EIGHT HOURS BEFORE TANK IS TO BE INSPECTED.

Final Inspection 2-18 1971 Approved (✓) Disapproved ( )

Remarks

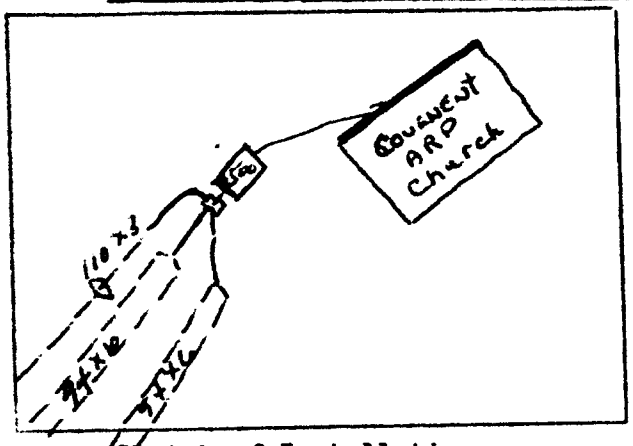

Sketch of Installation

Sanitarian