IREDELL COUNTY HEALTH DEPARTMENT

Statesville Phone TR 3-7271 Mooresville Phone NO 3-1271

PERMIT TO INSTALL SEPTIC TANK

Permit NO._____ Permit Date 8-27 1963

Owner MANRY GASTON Address STA.

Installed By H. HEDRICK Address STA.


Location of Property ON #64 E. RIGHT AT CHAT-N. N. BALE 2ND HOUSE ON LEFT BETWEEN [PAUL BRANCH CLYDE BOEN.

Tank		Capacity		Length of Lines		Fixtures	
Block	( )	800	( )	150'	( )	No. of Baths	(1½)
Precast	(X)	900	( )	175'	( )	Dishwasher	( )
		1000	(X)	200'	( )	Garbage Grdr.	( )
		1100	( )	225'	(X)	Auto-Washer	( )
		1200	( )	250'	( )	Other_____	
		Other_____		Other_____			

NOTIFY HEALTH DEPARTMENT AT LEAST EIGHT HOURS BEFORE TANK IS TO BE INSPECTED.

Final Inspection 8-27 1963 Approved (X) Disapproved ( )

Remarks GOOD

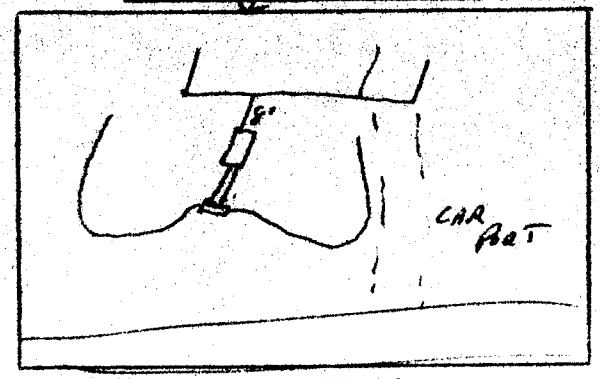

Sketch of Installation

Raymond A. Lemmon

Sanitarian