IREDELL COUNTY HEALTH DEPARTMENT

STATESVILLE 704-878-5305 MOORESVILLE 704-664-5281

51171

IMPROVEMENT PERMIT / CERTIFICATE OF COMPLETION / OPERATION PERMIT / EXISTING SYSTEM INSPECTION

PROPERTY DESCRIPTION NO. 18266 DATE 4-25-94 TAX MAP NO. 55-1-A-10 Watershed: ☐ Yes ☑ No

OWNER OR CONTRACTOR Russell Beck PHONE: Business Home 872-9948

ADDRESS 2916 mocksville Hwy US 64 E

LOCATION US 64 E past ~~Not~~ Chambers 1st lot on Rt

SUBDIVISION D.M. Parlier BLOCK / SECTION LOT LOT AREA 100'x400' SITE CLASS PS DESIGN FLOW 360 L.T.A.R. .35

Septic Tank: 1000 Gallons; STB 1012 Date 9-1-94

Pump Tank: Gallons; PT Date

Pump Make: Model Serial No.

Nitrification Field: No Beds 1 Square Feet 1050 Linear Feet 350

No Lines 5 Trench Width 36" Max Trench Bottom Depth 36" Gravel Depth 12"

☑ New System ☐ Repair System Type: I, II, III, IV, V, VI

System Description: Conv. Gravity

Repair System Description: Pump to conv. lines

Maintenance Agreement Required: ☐ Yes ☑ No

☑ House/Mod. Home No. Bedrooms 3

☐ Mobile Home No. Bathrooms 2½

☐ Business No. Employees

☐ Other


☐ Slab ☑ Crawl Space ☐ Basement w/plumbing ☐ Basement wo/plumbing

Water Supply: ☐ Individual ☐ Community ☑ Public

Comments:

Comments:

INITIAL SITE SKETCH

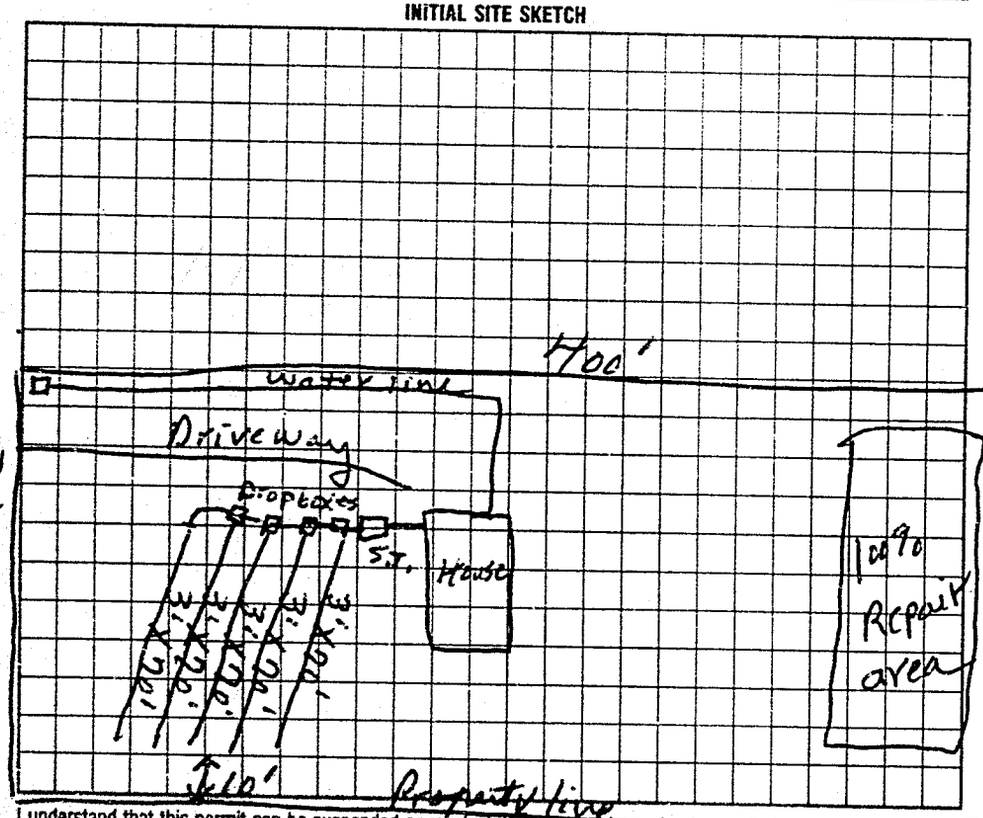

AS BUILT SKETCH

Same as initial sketch

I understand that this permit can be suspended or revoked if any false information is supplied toward securing the permit/any unauthorized changes are made to the site/any unauthorized changes are made in the installation of the system. Improvement Permit is valid for 60 months from date of issuance.

Signed: X Russell W. Beck

Improvement Permit by: L.C. Moore date 4-25-94

Existing System Inspection by: date

Installed by: AAA Enterprizes

Certificate of Completion by: L.C. Moore date 11-16-94

Operation Permit by: date

HEALTH DEPT. COPY: WHITE INSPECTION COPY (FINAL): GREEN OWNER COPY (FINAL): YELLOW INSPECTION COPY (INITIAL): PINK OWNER COPY (INITIAL): GOLD