IREDELL COUNTY HEALTH DEPARTMENT - *ENVIRONMENTAL HEALTH* ☑ STATESVILLE OFFICE 704-878-5305 ☐ MOORESVILLE OFFICE 704-664-5281

IMPROVEMENT PERMIT / AUTHORIZATION TO CONSTRUCT / OPERATION PERMIT / EXISTING SYSTEM INSPECTION

4-00 final

PERMIT # Relocation PIN # 4755-84-5712 DATE 13 January 2012

OWNER Linda Boutilier APPLICANT: Rick Boutilier PHONE: Home/Cell # (704) 213-0276 Business #

SITE ADDRESS 336 Mocksville Hwy OWNER / APPLICANT ADDRESS

SITE DIRECTIONS Hwy 64E 2nd House on Rt. Past J.B.'s Hotdogs

SUBDIVISION BLOCK / SECTION LOT # LOT AREA 20,400 Ft² DESIGN FLOW 360 gpd L.T.A.R. 0.3 gpd/ft²

Septic Tank 1000 Gallons: STB 760 Date 7-9-11
Pump Tank Gallons: P T Date
Pump Make Model Serial #
No. Nitrification Fields: 1 No. Lines 5 Linear Feet 300
Trench Width 36" Max. Trench Bottom Depth 36" Gravel Depth N/A

☑ New System ☐ Repair ☐ Expansion System Type I II (III) IV V VI
System Description: 75% Reduction system.
Repair System Description: Maximum Feasible
Maintenance Agreement Required ☐ YES ☑ NO
☑ GRAVITY ☐ PRESSURE


☑ Residence No. Bedrooms 3
☐ Business No. Persons
☐ Other No. Employees
☐ Slab ☑ Crawl Space
☐ Basement w/plumbing ☐ Basement w/o plumbing

Water Supply
☑ Private - Exist.
☑ Public
☐ Community


Comments / Conditions: Remove large trees and relocate existing water line to allow for installation of septic system

* Maximum feasible repair area.
Pollute Filter-drawer. Installed as drawn. Supply line come out side of house 5'± off marked p/l.
#Septic lines 10'± off marked p/l

INITIAL SITE SKETCH

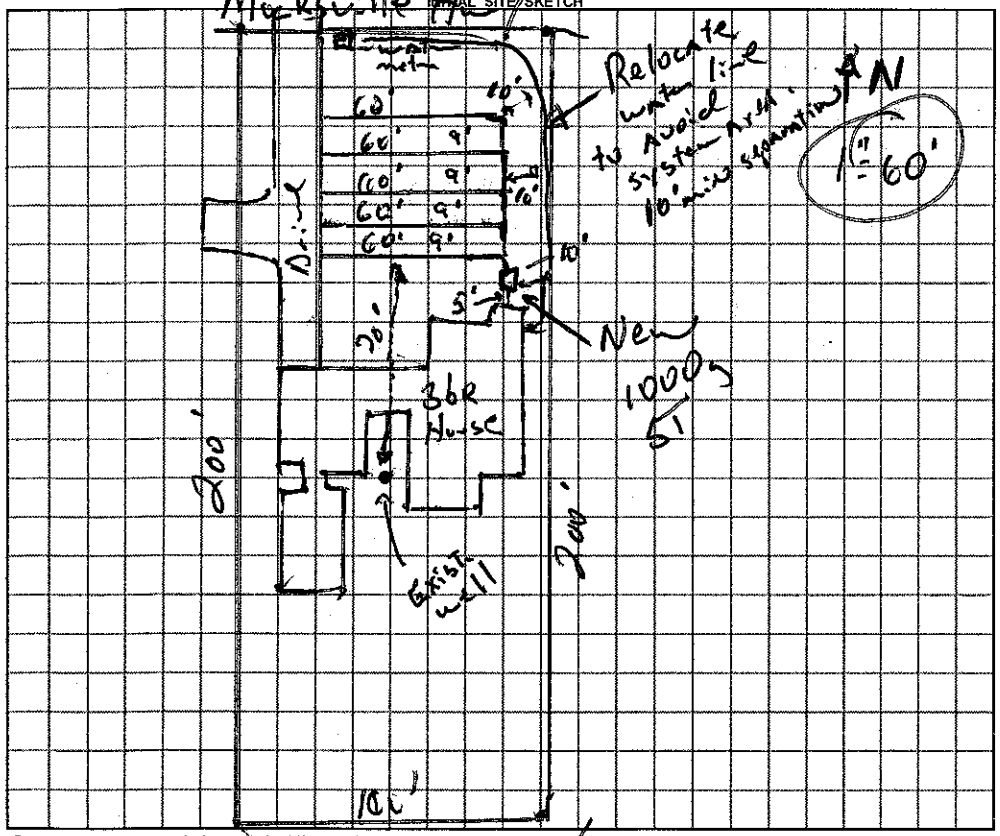

AS BUILT SKETCH

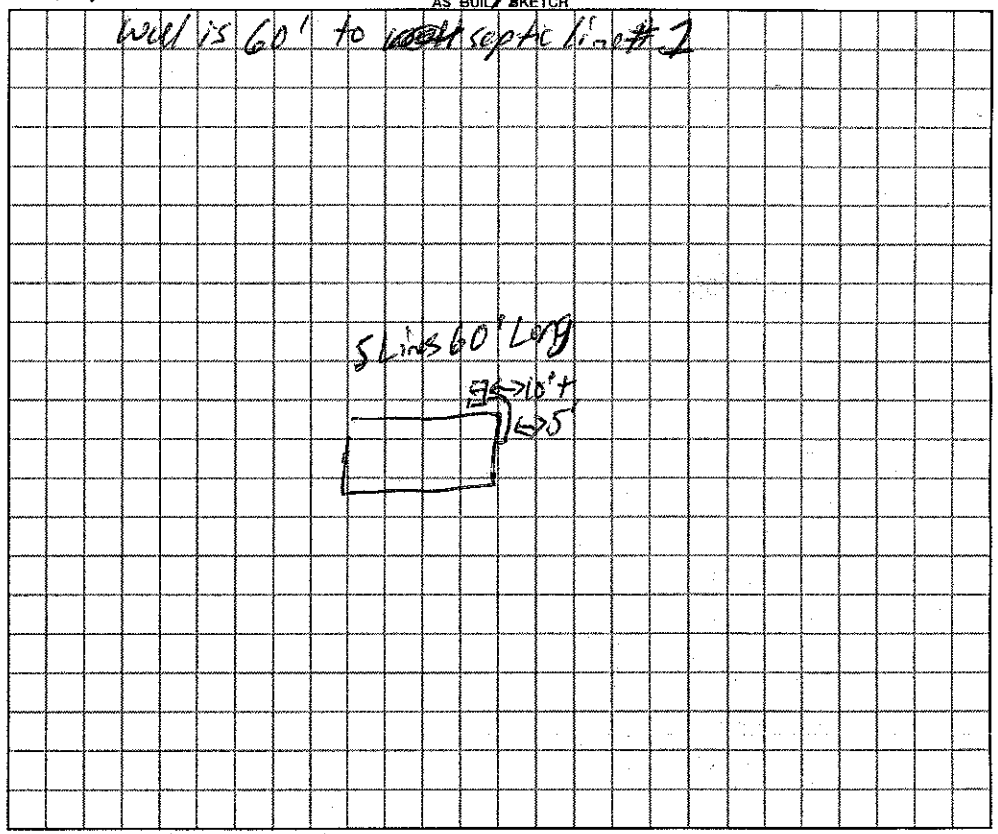

Permit can be suspended or revoked if any false information is supplied toward securing the permit / any unauthorized changes are made to the site / any unauthorized changes are made in the installation of the system.

☐ ***IMPROVEMENT PERMIT*** with plat valid without expiration. ☑ ***IMPROVEMENT PERMIT*** with plat ~~valid without expiration~~ site plan valid 60 mo. ☑ ***AUTHORIZATION TO CONSTRUCT*** valid for period equal to IMPROVEMENT PERMIT–not to exceed 60 mo.

Owner / Applicant Signature: Date 1/20/12 Installed by: Al Bakhel

IMPROVEMENT PERMIT by: REHS Date 17 Jan. 12 OPERATION PERMIT by: REHS Date 3-1-12

AUTHORIZATION TO CONSTRUCT by: REHS Date 17 Jan. 12 Existing System Inspected by: REHS Date

YOU SHOULD CONTACT A LOCATOR SERVICE PRIOR TO ANY EXCAVATION

White Copy – Environmental Health YELLOW COPY (Final) Owner / Applicant PINK COPY (Initial) Owner / Applicant