IREDELL COUNTY HEALTH DEPARTMENT

Statesville Phone TR 3-7271 Mooresville Phone NO 3-1271

PERMIT TO INSTALL SEPTIC TANK

Permit NO. CB County Bldg. Permit Date July 26 1968

Owner Joe? Kafer Address City

Installed By C Hoke Address R7


Location of Property Shannon Acres - 1st st off E. Bd St. 2nd st to R - then X Rd. 1st on R.

Tank		Capacity		Length of Lines		Fixtures	
Block	( )	1000	( )	225'	( )	No. of Baths	(3)
Precast	(✓)	1250	( )	250'	( )	Dishwasher	( )
		1500	( )	Other 675 sq ft.		Garbage Grdr.	( )
		Other				Other	

NOTIFY HEALTH DEPARTMENT AT LEAST EIGHT HOURS BEFORE TANK IS TO BE INSPECTED.

Final Inspection 19 Approved ( ) Disapproved ( )

Remarks Heavily wooded. deep due to plumbing rough out. well 100'

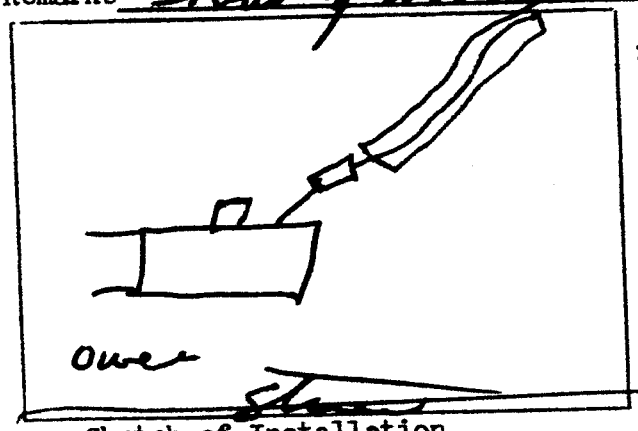

Sketch of Installation

Sanitarian