IREDELL COUNTY HEALTH DEPARTMENT

Statesville Phone TR 3-7271 Mooresville Phone NO 3-1271

PERMIT TO INSTALL SEPTIC TANK

Permit NO. Watts Permit Date Aug. 29 - 1961

Owner Dr. Underwood Address Country Club.

Installed By C Hoke Address RFD


Location of Property 1st street to R. - Right on Y end of pavement on left.

Tank		Capacity		Length of Lines		Fixtures	
Block	( )	800	( )	150'	( )	No. of Baths	(2½)
Precast	(✓)	900	( )	175'	( )	Dishwasher	( )
Local		1000	( )	200'	( )	Garbage Grdr.	( )
		1100	( )	225'	( )	Auto-Washer	( )
		1200	( )	250'	( )	Other	
		Other 1250		Other 270'			

NOTIFY HEALTH DEPARTMENT AT LEAST EIGHT HOURS BEFORE TANK IS TO BE INSPECTED.

Final Inspection Aug 29 1961 Approved (✓) Disapproved ( )

Remarks Have 100'

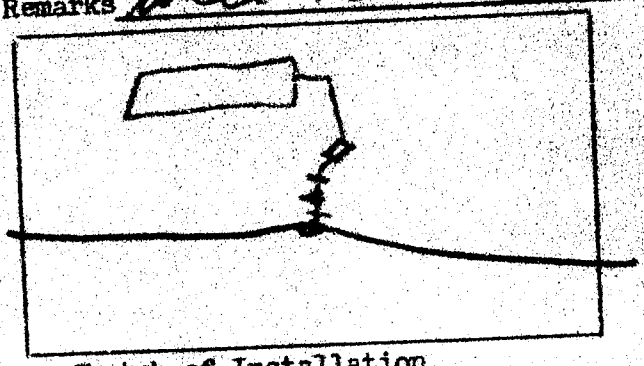

Sketch of Installation

Checked By R Johnson

Sanitarian