IREDELL COUNTY HEALTH DEPARTMENT

Statesville Phone TR 3-7271 Mooresville Phone NO 3-1271

PERMIT TO INSTALL SEPTIC TANK

Permit NO. _____ Permit Date Jan 5 1961

Owner Loyd Reynolds Address East Broad St Ext. Statesville N.C.

Installed By Clyde Wike Address Statesville


Location of Property Out East Broad 1st House on right in County Ind Estates.

Tank		Capacity		Length of Lines		Fixtures	
Block	( )	800	( )	150'	( )	No. of Baths	(2)
Precast	(✓)	900	( )	175'	( )	Dishwasher	(✓)
		1000	(✓)	200'	( )	Garbage Grdr.	(—)
		1100	( )	225'	( )	Auto-Washer	(✓)
		1200	( )	250'	(✓)	Other _____	
		Other _____		Other _____			

NOTIFY HEALTH DEPARTMENT AT LEAST EIGHT HOURS BEFORE TANK IS TO BE INSPECTED.

Final Inspection Jan 5 1961 Approved (✓) Disapproved ( )

Remarks all trees 10 ft out on side of lines Must be Cut

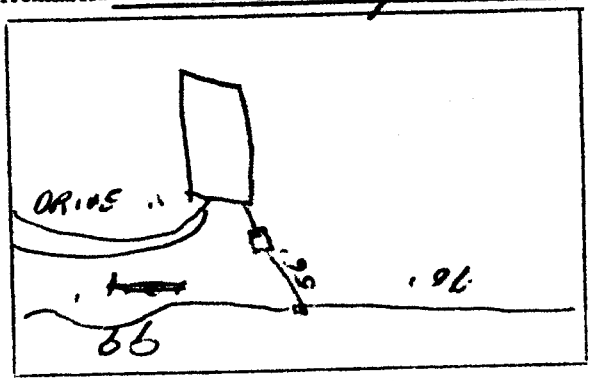

Sketch of Installation

R. W. Johnson

Sanitarian