IREDELL COUNTY HEALTH DEPARTMENT

Statesville Phone TR 3-7271 Mooresville Phone NO 3-12?1

PERMIT TO INSTALL SEPTIC TANK

Permit NO. _____ Permit Date Feb 7 19 64

Owner Albert Scinder Address Shanon Acres -

Installed By C Hoke Address _____


Location of Property Right on 1st Street in to New Country Club - Rt 1st St. 1st on left -

Tank		Capacity		Length of Lines		Fixtures	
Block	(✓)	800	( )	150'	( )	No. of Baths	(6)
Precast	( )	900	( )	175'	( )	Dishwasher	( )
		1000	( )	200'	( )	Garbage Grdr.	( )
		1100	( )	225'	( )	Auto-Washer	( )
		1200	( )	250'	( )	Other extra sink	
		Other _____		Other 400' 5" und			

NOTIFY HEALTH DEPARTMENT AT LEAST EIGHT HOURS BEFORE TANK IS TO BE INSPECTED.

Final Inspection 2-7 1964 Approved (✓) Disapproved ( )

Remarks Well 100' Heavily wooded

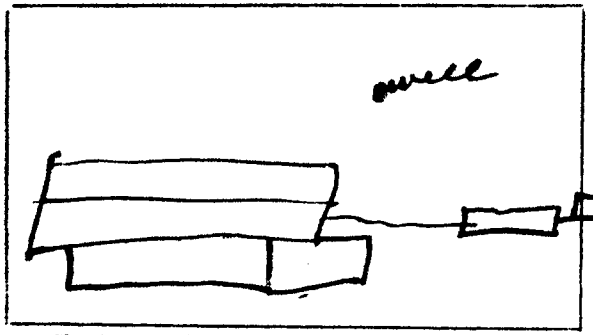

Sketch of Installation

RLT

Sanitarian