IREDELL COUNTY HEALTH DEPARTMENT

Statesville Phone TR 3-7271 Mooresville Phone NO 3-1271

PERMIT TO INSTALL SEPTIC TANK

Permit NO. # G H Bllers. Permit Date Sept 24 1964

Owner Paul Holder Address Shannon Ave

Installed By Clyde Hoke Address RT -


Location of Property 1st street into Shannon Acres in 2nd block on R.

Tank		Capacity		Length of Lines		Fixtures	
Block	( )	800	( )	150'	( )	No. of Baths	(2½)
Precast	(✓)	900	( )	175'	( )	Dishwasher	( )
		1000	(✓)	200'	( )	Garbage Grdr.	( )
		1100	( )	225'	(✓)	Auto-Washer	( )
		1200	( )	250'	( )	Other	
		Other		Other	240'		

NOTIFY HEALTH DEPARTMENT AT LEAST EIGHT HOURS BEFORE TANK IS TO BE INSPECTED.

Final Inspection 9-24 1964 Approved (✓) Disapproved ( )

Remarks Well 75' Heavily wooded Very deep due to layout of tank and lot

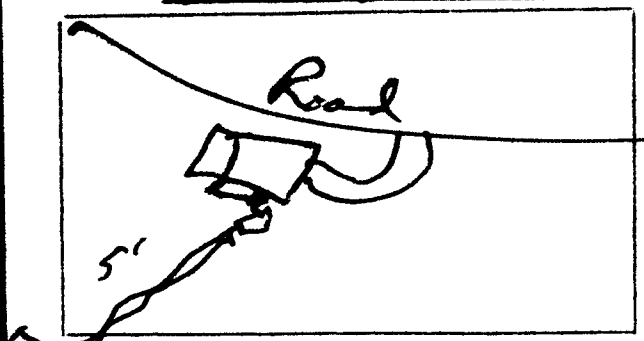

Sketch of Installation

R.t.

Sanitarian