IREDELL COUNTY HEALTH DEPARTMENT

Statesville Phone TR 3-7271 Mooresville Phone NO 3-1271

PERMIT TO INSTALL SEPTIC TANK

Permit NO. _____ Permit Date Aug 18 1965

Owner Marcus Gunter Address Statesville, N.C.

Installed By Riley Link Address 605 Statesville Ave.

Location of Property Old Lock of on Shiloh Church


Farm

Tank		Capacity		Length of Lines		Fixtures	
Block	( )	1000	(✓)	225'	(✓)	No. of Baths	( )
Precast	(✓)	1250	( )	250'	( )	Dishwasher	( )
		1500	( )	Other _____		Garbage Grdr.	( )
		Other _____				Other _____	

NOTIFY HEALTH DEPARTMENT AT LEAST EIGHT HOURS BEFORE TANK IS TO BE INSPECTED.

Final Inspection Aug 18 1965 Approved (✓) Disapproved ( )

Remarks _____

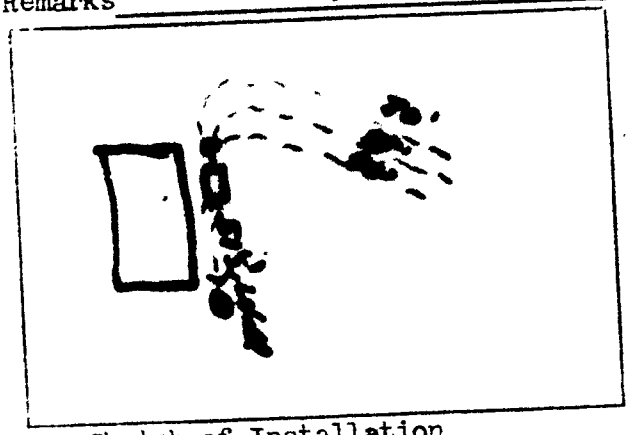

Sketch of Installation

Robert L. Johnson R.S.

Sanitarian