IREDELL COUNTY HEALTH DEPARTMENT

Statesville Office (704) 878-5305 Mooresville Office (704) 660-3625 PERMIT # 214693

IMPROVEMENT PERMIT / AUTHORIZATION TO CONSTRUCT / OPERATION PERMIT / EXISTING SYSTEM

PIN # 4755947931

APPLICANT: Matt Myers Construction APPLICANT ADDRESS: 190 Meadow Oaks Dr Statesville NC 28625

SITE ADDRESS: 397 Mocksville Hwy Statesville NC PHONE: 704-902-1017 ALT. PHONE: N/A

SITE DIRECTIONS: 40 E T/R old Mocksville Hwy T/L Mocksville Hwy Lot on left

SUBDIVISION: N/A SECTION: N/A LOT # N/A LOT AREA: 2.15ac DESIGN FLOW: Ex L.T.A.R.: Ey

Septic Tank	Ey	(gal)	STB	Date					
Pump Tank		(gal)	PT	Date					
Pump Make		Model		Serial #					
# Nitrification Fields	Ey	# Lines	Ey	Linear Ft:	Ey				
Trench Width	Ey	Max. Trench Bottom Depth	Ey	Gravel Depth	Ey				

☐ New System ☐ Repair ☐ Expansion System Type: I (II) III IV V VI

System Description: Existing

Repair System Description:

Maintenance Agreement Required: ☐ YES ☒ NO

☒ GRAVITY ☐ PRESSURE

☒ Residence No. Bedrooms Ex

☐ Business No. Persons Ey

☐ Other No. Employees


☐ Slab ☒ Crawl Space

☐ Basement w/plumbing ☐ Basement w/o plumbing

Water Supply: ☐ Private ☒ Public ☐ Community


Comments / Conditions: All building foundations must be 25' from any/a well and 5' from any part of STS.

INITIAL SITE SKETCH

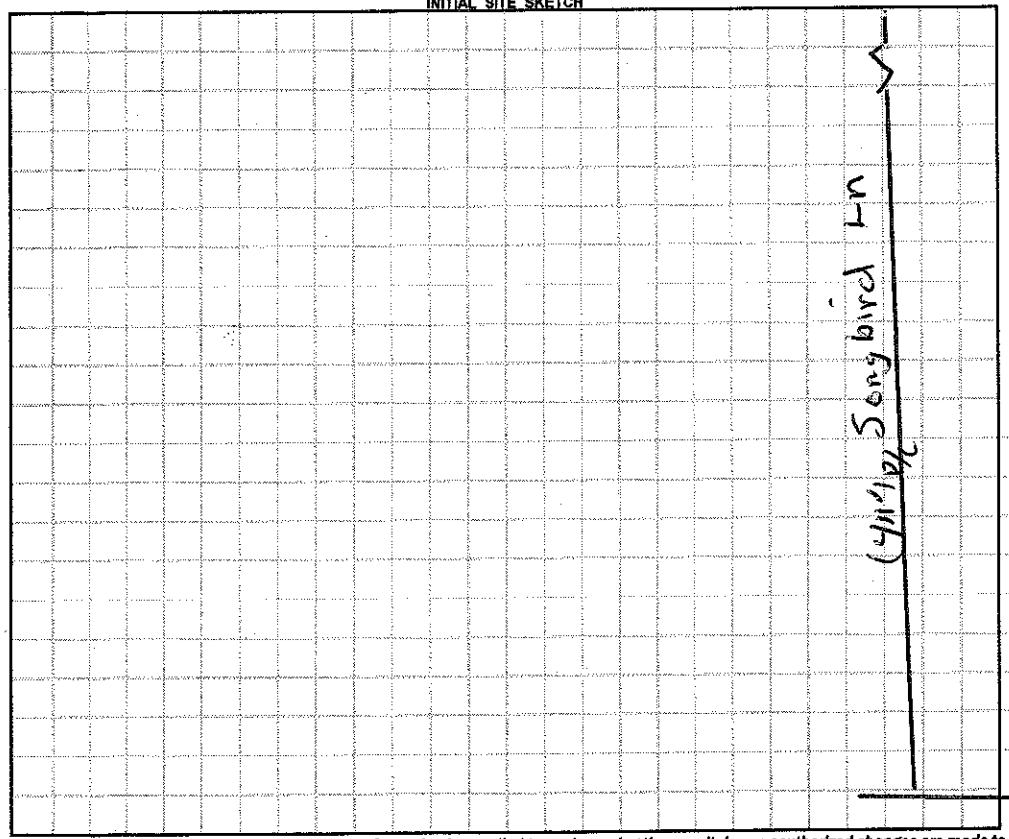

STS Area

AS BUILT SKETCH

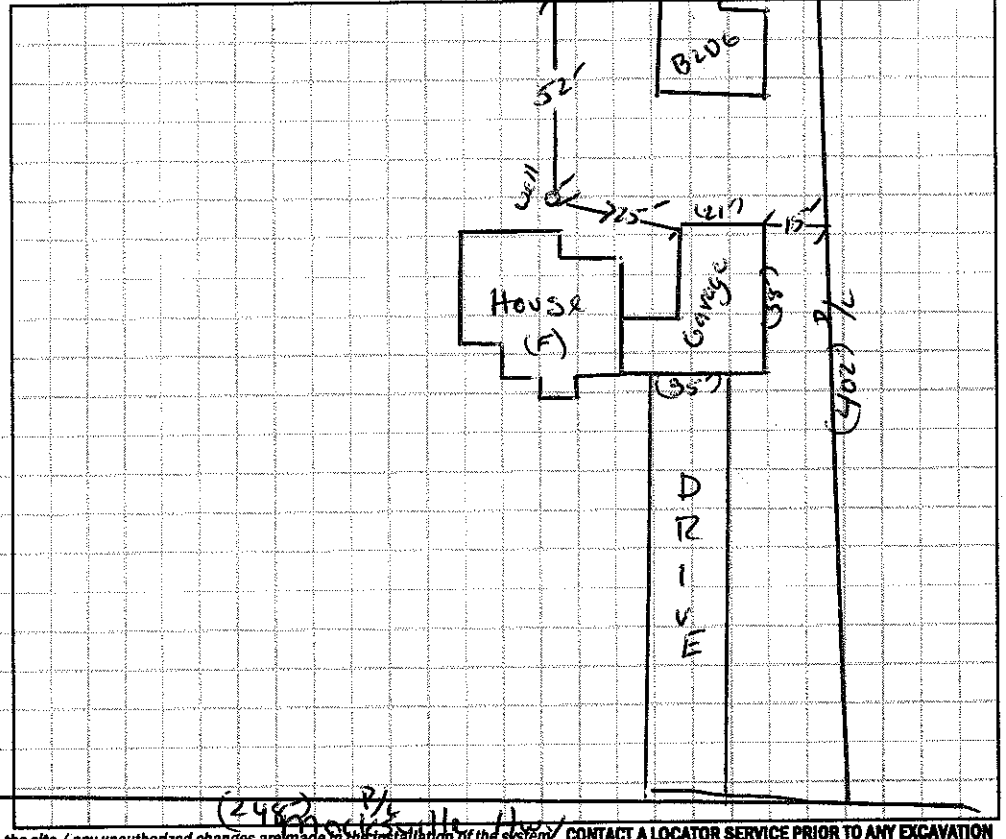

Permit can be suspended or revoked if any false information is supplied toward securing the permit / any unauthorized changes are made to the site / any unauthorized changes are made in the installation of the system. **CONTACT A LOCATOR SERVICE PRIOR TO ANY EXCAVATION**

☐ **IMPROVEMENT PERMIT** *with plat valid without expiration.* ☐ **IMPROVEMENT PERMIT** *with site plan valid for 60 mos.* ☐ **AUTHORIZATION TO CONSTRUCT** *valid for period equal to IMPROVEMENT PERMIT--not to exceed 60 mo.*

Owner / Applicant Signature: Date: 12-18-15 Installed by:

IMPROVEMENT PERMIT by: Date: OPERATION PERMIT by: Date:

AUTHORIZATION TO CONSTRUCT by: Date: Existing System Inspected by: Date: 12/17/15

Health Dept. Copy - WHITE Applicant (Final Approval) - YELLOW Applicant (Conditional Approval) - PINK