IREDELL COUNTY HEALTH DEPARTMENT

STATESVILLE 704-878-5305 MOORESVILLE 704-664-5281

IMPROVEMENT PERMIT / AUTHORIZATION TO CONSTRUCT / OPERATION PERMIT / EXISTING SYSTEM INSPECTION

PERMIT# REPAIR PIN# 4755951058 DATE 05-13-05

OWNER OR CONTRACTOR DELBERT DICKENS PHONE: Business Home 704-872-0370

ADDRESS 359 MOCKSVILLE HWY STATESVILLE NC 28625

LOCATION 64 EAST, @ AT BOX # 359 RIGHT PAST JAY BEE'S

SUBDIVISION BLOCK / SECTION LOT 55 LOT AREA SITE CLASS. DESIGN FLOW 240 L.T.A.R.

Septic Tank: EXISTING Gallons; STB ≈ 800 GAL Date

Pump Tank: Gallons; PT Date

Pump Make: Model Serial No.

Nitrification Field: No Fields 1 Square Feet Linear Feet 150'

No Lines 3 x 50' Trench Width 36" Max Trench Bottom Depth Gravel Depth (24")

☐ New System ☒ Repair System Type: I, (II), III, IV, V, VI

System Description: CONV GRAV

Repair System Description:

Maintenance Agreement Required: ☐ Yes ☐ No

☐ House/Mod. Home No. Bedrooms 3

☐ Mobile Home No. Bathrooms 1

☐ Business No. Employees

☐ Other


☐ Slab ☒ Crawl Space ☐ Basement w/plumbing ☐ Basement wo/plumbing

Water Supply: ☐ Individual ☒ Public ☐ Community


Comments/Conditions: (1) INSTALL 3 LINES 50' LONG & 24" STONE (2) CALL PRIOR TO INSTALLATION FOR CONSULTATIVE VISIT (3) SET DIST. BOX WITH SPEED LEVELERS SO ALL LINES WILL

Comments/Conditions: BACK UP TO BOX (4) TANK HAS BAFFLE WALL & NEW TEE (5) REMOVE MAPLE TREE'S IN FRONT YARD. (6) THIS PERMIT SERVES AS NOTICE OF VIOLATION & MUST BE REPAIRED WITHIN 30 DAYS.

INITIAL SITE SKETCH

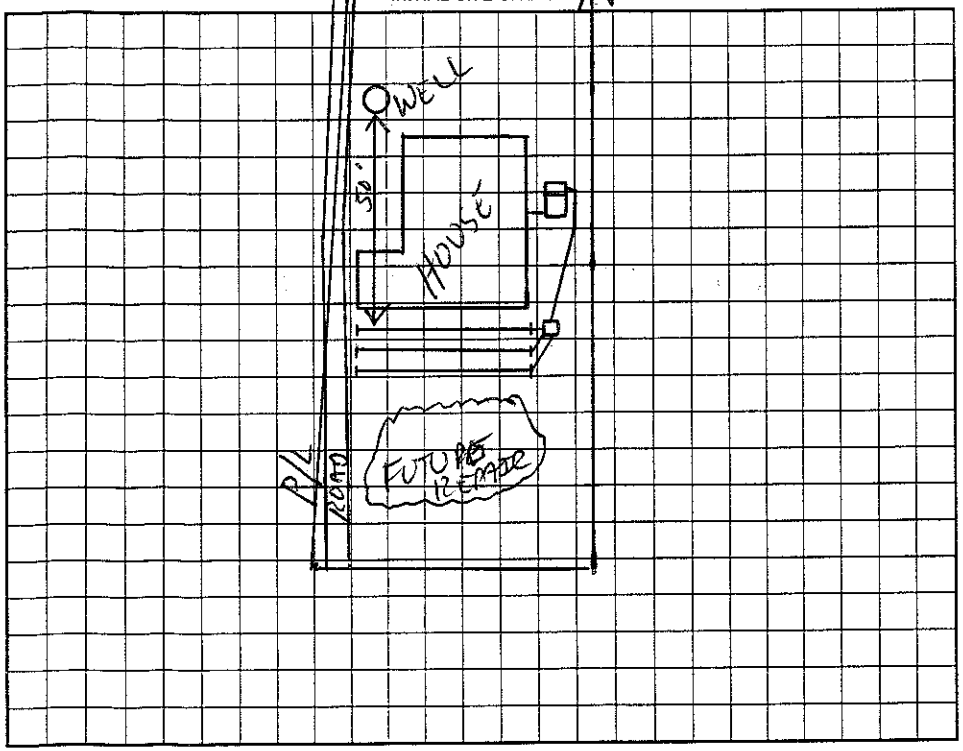

AS BUILT SKETCH

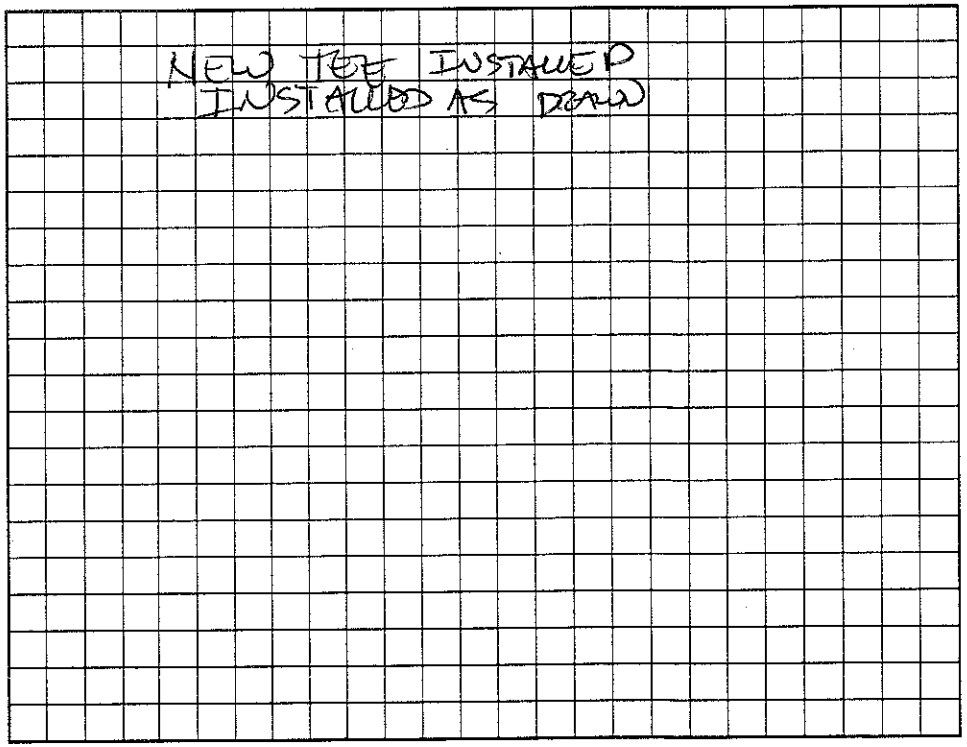

Permit can be suspended or revoked if any false information is supplied toward securing the permit/any unauthorized changes are made to the site/any unauthorized changes are made in the installation of the system. Improvement Permit with plat valid without expiration. Improvement Permit with site plan valid for sixty months. Authorization to Construct is valid for a period equal to that of Improvement Permit – not to exceed sixty months.

Signed: Delbert G. Dickens date 9/2/05 Installed by: A-1 BACKHOE

Improvement Permit by: date 5-13-05 Operation Permit by: date 5-25-06

Authorization to Construct by: date 5-13-05 Existing System Inspection by: date

HEALTH DEPT. COPY: WHITE OWNER COPY (FINAL): YELLOW OWNER COPY (INITIAL): PINK