IREDELL COUNTY HEALTH DEPARTMENT

Statesville Office (704) 878-5305 Mooresville Office (704) 660-3625 PERMIT # 177069

IMPROVEMENT PERMIT / AUTHORIZATION TO CONSTRUCT / OPERATION PERMIT / EXISTING SYSTEM

PIN # 4756039933

APPLICANT: Live Oak Realty Development LLC APPLICANT ADDRESS: 145 Cooper Leaf Ln.

SITE ADDRESS: 398 Jane Sowers Rd. PHONE: 704-935-0961 ALT. PHONE: N/A

SITE DIRECTIONS: Hwy 21 N TR Jane Sowers Rd.

SUBDIVISION: N/A SECTION: N/A LOT # N/A LOT AREA: 1.02 acres DESIGN FLOW: 240 gpd L.T.A.R.: 0.25

Septic Tank Existing (gal) STB 766 Date 12-20-12
Pump Tank (gal) PT Date
Pump Make Model Serial #
Nitrification Fields 1 # Lines 4 Linear Ft: 240
Trench Width 36" Max. Trench Bottom Depth 36" Gravel Depth N/A


☐ New System ☑ Repair ☐ Expansion System Type: I II III IV V VI
System Description:
Repair System Description: 25% Reduction
Maintenance Agreement Required: ☐ YES ☑ NO ☑ GRAVITY ☐ PRESSURE

☑ Residence No. Bedrooms 2
☐ Business No. Persons
☐ Other No. Employees
☐ Slab ☑ Crawl Space
☐ Basement w/plumbing ☐ Basement w/o plumbing

Water Supply: ☐ Private ☑ Public ☐ Community

Comments / Conditions: Install a 25% Reduction system on Contour with serial distribution. Replace Septic tank and/or tee if needed. Grade out water terrace shown in drawing below.

INITIAL SITE SKETCH

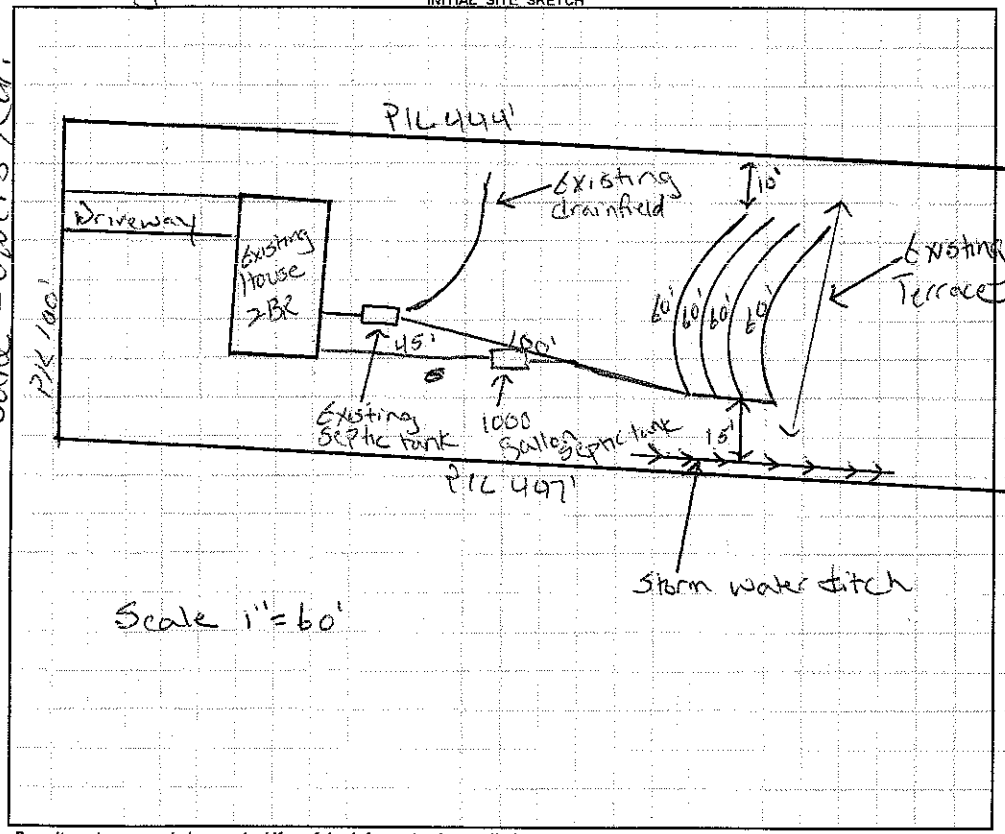

AS BUILT SKETCH

- Existing septic tank was pumped & crushed
- Red Poly/ok filter installed
- Quick 4 Chambers installed
- Installed as drawn

Permit can be suspended or revoked if any false information is supplied toward securing the permit / any unauthorized changes are made to the site / any unauthorized changes are made in the installation of the system. **CONTACT A LOCATOR SERVICE PRIOR TO ANY EXCAVATION**

☐ **IMPROVEMENT PERMIT** *with plat* valid without expiration. ☑ **IMPROVEMENT PERMIT** *with site plan* valid for 60 mos. ☑ **AUTHORIZATION TO CONSTRUCT** valid for period equal to IMPROVEMENT PERMIT--not to exceed 60 mo.

Owner / Applicant Signature: Douglas L Munn Date: Installed by: A1 Backhoe

IMPROVEMENT PERMIT by: Justin Henderson Date: 2-19-13 OPERATION PERMIT by: Justin Henderson Date: 3-15-13

AUTHORIZATION TO CONSTRUCT by: Justin Henderson Date: 2-19-13 Existing System Inspected by: Date:

Health Dept. Copy - WHITE Applicant (Final Approval) - YELLOW Applicant (Conditional Approval) - PINK