# IREDELL COUNTY HEALTH DEPARTMENT

STATESVILLE 704-878-5305 MOORESVILLE 704-664-5281

## IMPROVEMENT PERMIT / AUTHORIZATION TO CONSTRUCT / OPERATION PERMIT / EXISTING SYSTEM INSPECTION

PERMIT# REPAIR PIN# 4756-04-7652 DATE 3-21-07

OWNER OR APPLICANT ANTHONY TY HAWLEY PHONE: Business 704-609-7962 Home 704-838-1000

ADDRESS 166 DANBURY LANE, STATESVILLE, NC 28625

LOCATION US 21 NORTH, TR JANE SOMERS ROAD, TL DANBURY LANE, 2ND DRIVE ON LEFT

SUBDIVISION DANBURY FOREST BLOCK / SECTION ____ LOT 4 LOT AREA <1 ACRE SITE CLASS. PS DESIGN FLOW 360 L.T.A.R. EXISTING

NEW

Septic Tank: 1000 Gallons; STB 1072 Date 1-23-06

Pump Tank: ____ Gallons; PT ____ Date ____

Pump Make: ____ Model ____ Serial No. ____

Nitrification Field: No Fields 1 Square Feet EXISTING Linear Feet EXISTING

No Lines TWO Trench Width EXIST. Max Trench Bottom Depth EXIST. Gravel Depth N/A

☐ New System ☑ Repair ☐ Expansion System Type: I II III IV V VI

System Description: ____

Repair System Description: CONVENTIONAL, GRAVITY

Maintenance Agreement Required: ☑ Yes ☐ No

☑ Gravity ☐ Pressure

☑ House/Mod. Home No. Bedrooms 3

☐ Mobile Home No. Persons ____

☐ Business No. Employees ____

☐ Other ____


☐ Slab ☑ Crawl Space ☐ Basement w/plumbing ☐ Basement wo/plumbing

Water Supply: ☐ Individual ☑ Public ☐ Community


Comments:/Conditions: (1) EXCAVATE EXISTING SEPTIC TANK & REPLACE W/ NEW 1000 GALLON TANK AS SHOWN (2) EXCAVATE EXISTING LINE FIVE FEET FROM NEW BUILDING CONSTRUCTION.

Comments:/Conditions: (3) READJUST DISTRIBUTION BOX WITH SPEED LEVELERS

INITIAL SITE SKETCH ~ SCALE: 1" = 40'

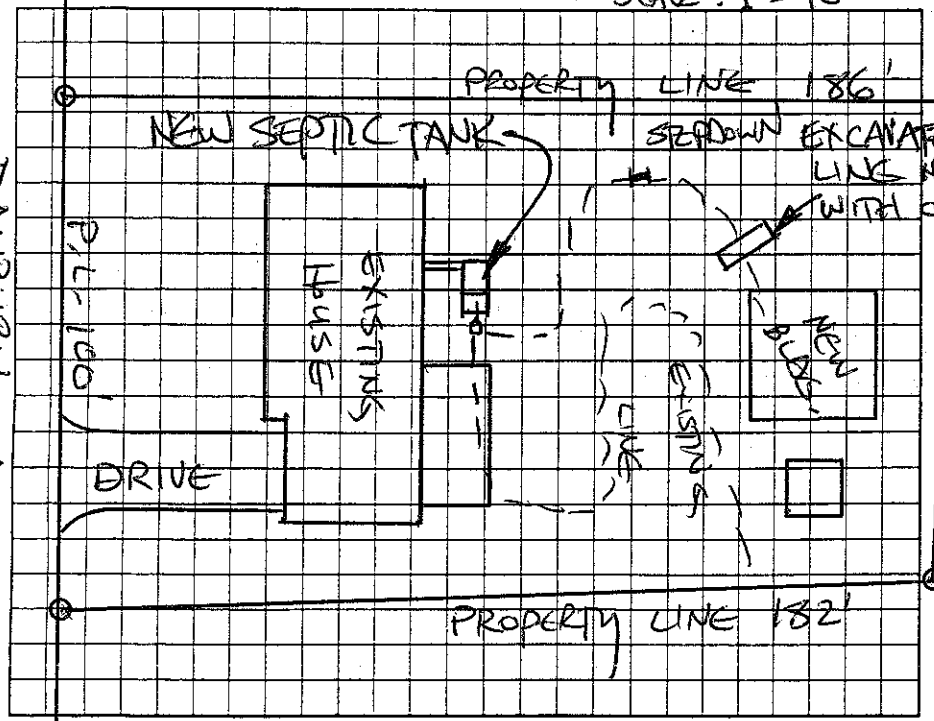


AS BUILT SKETCH

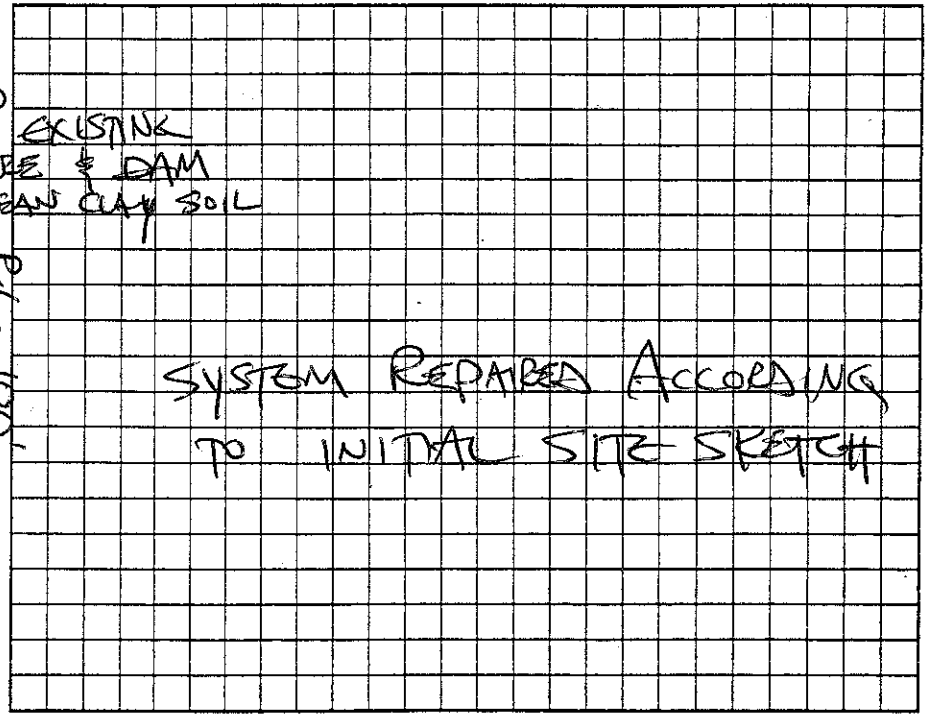


Permit can be suspended or revoked if any false information is supplied toward securing the permit/any unauthorized changes are made to the site/any unauthorized changes are made in the installation of the system. Improvement Permit with plat valid without expiration ☐ Improvement Permit with site plan valid for sixty months ☑ Authorization to Construct is valid for a period equal to that of Improvement Permit – not to exceed sixty months.

Signed: [signature] date 3-23-07

Improvement Permit by: STEVE HEDRICK date 3-21-07

Authorization to Construct by: STEVE HEDRICK date 3-21-07

Installed by: A-1 BACKHOE

Operation Permit by: STEVE HEDRICK date 5-16-07

Existing System Inspection by: ____ date ____

HEALTH DEPT. COPY: WHITE OWNER COPY (FINAL): YELLOW OWNER COPY (INITIAL): PINK