12:00

IREDELL COUNTY HEALTH DEPARTMENT

STATESVILLE 704-878-5305 MOORESVILLE 704-664-5281

IMPROVEMENT PERMIT / CERTIFICATE OF COMPLETION / OPERATION PERMIT / EXISTING SYSTEM INSPECTION

PROPERTY DESCRIPTION NO. ______ DATE 10-20-95 TAX MAP NO. ______ Watershed: ☐ Yes ☐ No

OWNER OR CONTRACTOR Steve Hill PHONE: Business ______ Home 876-0008

ADDRESS 151 Danbury Lane

LOCATION 21N JR Jane Sowers TL Danbury 5th House Rt.

SUBDIVISION Danbury Forest BLOCK / SECTION ______ LOT ______ LOT AREA ______ SITE CLASS. PS DESIGN FLOW 360 L.T.A.R. .3

Septic Tank: ______ Gallons; STB ______ Date ______

Pump Tank: ______ Gallons; PT ______ Date ______

Pump Make: ______ Model ______ Serial No. ______

Nitrification Field: No Fields 2 Square Feet 780 Linear Feet 260

No Lines 4 Trench Width 3' Max Trench Bottom Depth 36" Gravel Depth 12"

☐ New System ☑ Repair System Type: I, II, III, IV, V, VI

System Description: ______

Repair System Description: Conv. Gravity

Maintenance Agreement Required: ☐ Yes ☐ No

☐ Slab ☑ Crawl Space ☐ Basement w/plumbing ☐ Basement wo/plumbing

☑ House/Mod. Home ☐ Mobile Home ☐ Business ☐ Other ______


No. Bedrooms 3 No. Bathrooms 2 No. Employees ______

Water Supply: ☐ Individual ☐ Community ☑ Public

Comments: Water meter + line must be rerouted around area of Repair

Comments: ______

INITIAL SITE SKETCH

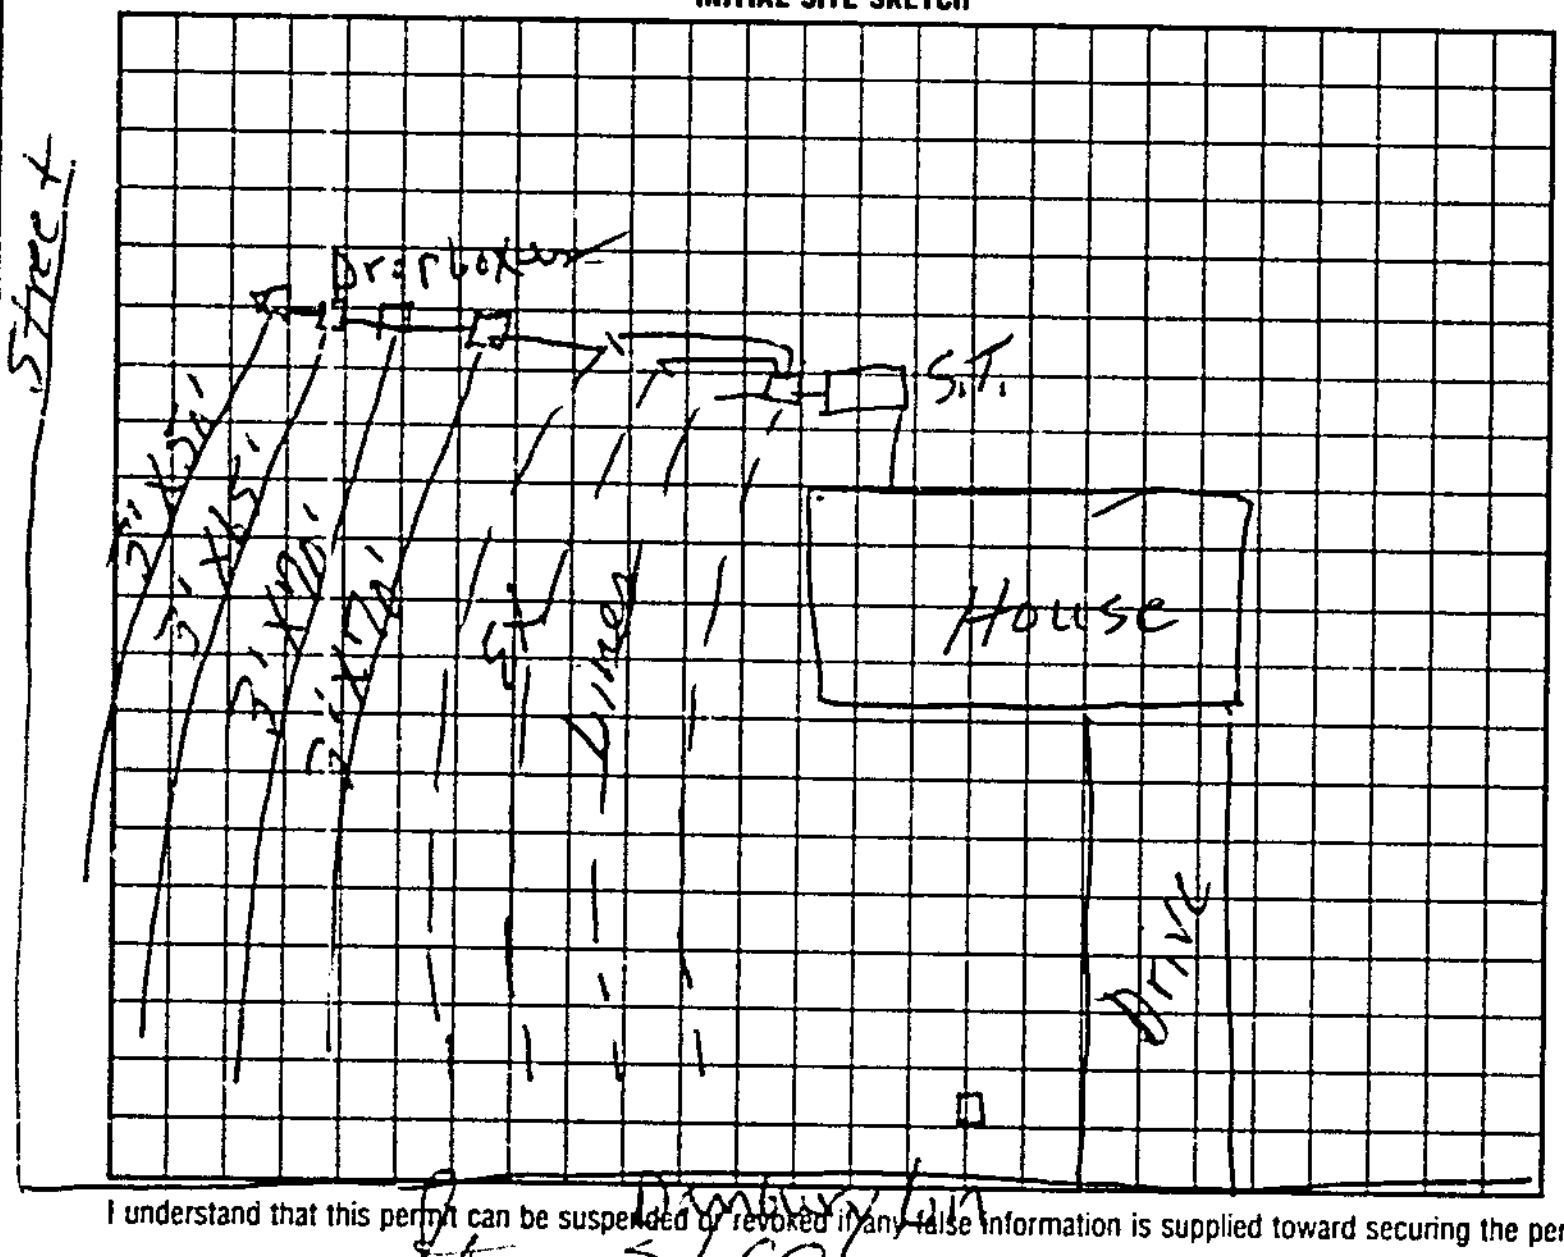

AS BUILT SKETCH

Same as initial Sketch

I understand that this permit can be suspended or revoked if any false information is supplied toward securing the permit/any unauthorized changes are made to the site/any unauthorized changes are made in the installation of the system.

Signed: x Steve Hill

Installed by: Craig Thompson

Improvement Permit by: L.C. Moore date 10-20-95

Certificate of Completion by: ______ date ______

Authorization to Construct / Existing System Inspection by: L.C. Moore date 10-20-95

Operation Permit by: L.C. Moore date 2-13-96

HEALTH DEPT. COPY: WHITE INSPECTION COPY (FINAL): GREEN OWNER COPY (FINAL): YELLOW INSPECTION COPY (INITIAL): PINK OWNER COPY (INITIAL): GOLD

Authorization to Const Expires 60 mos from date of issue

162000