IREDELL COUNTY HEALTH DEPARTMENT - *ENVIRONMENTAL HEALTH* ☑ STATESVILLE OFFICE 704-878-5305 ☐ MOORESVILLE OFFICE 704-664-5281

IMPROVEMENT PERMIT / AUTHORIZATION TO CONSTRUCT / OPERATION PERMIT / EXISTING SYSTEM INSPECTION

PERMIT # 16917 PIN # 4756051791 DATE 6-23-11

OWNER Daniel Waksmun APPLICANT: Joey Eldridge PHONE: Home/Cell # 704-878-2531 Business #

SITE ADDRESS 190 Carl Austin Rd OWNER / APPLICANT ADDRESS

SITE DIRECTIONS Hwy 21 (R) on Jane Sowers; (L) on Carl Austin

SUBDIVISION n/a BLOCK / SECTION n/a LOT # n/a LOT AREA 101 Ac DESIGN FLOW 360 L.T.A.R. 3

Septic Tank existing Gallons: STB Date
Pump Tank Gallons: P T Date
Pump Make Model Serial #
No. Nitrification Fields: 1 No. Lines Linear Feet 300
Trench Width 36" Max. Trench Bottom Depth 36" Gravel Depth 36"


☒ New System ☐ Repair ☐ Expansion System Type I II (III) IV V VI
System Description: 25% Reduction Gravity
Repair System Description:
Maintenance Agreement Required ☐ YES ☒ NO
☒ GRAVITY ☐ PRESSURE

☒ Residence No. Bedrooms 3
☐ Business No. Persons
☐ Other No. Employees
☐ Slab ☒ Crawl Space
☐ Basement w/plumbing ☐ Basement w/o plumbing


Water Supply
☐ Private
☐ Public
☒ Community

Comments / Conditions
May install a new 1000 gal. min tank if necessary

INITIAL SITE SKETCH

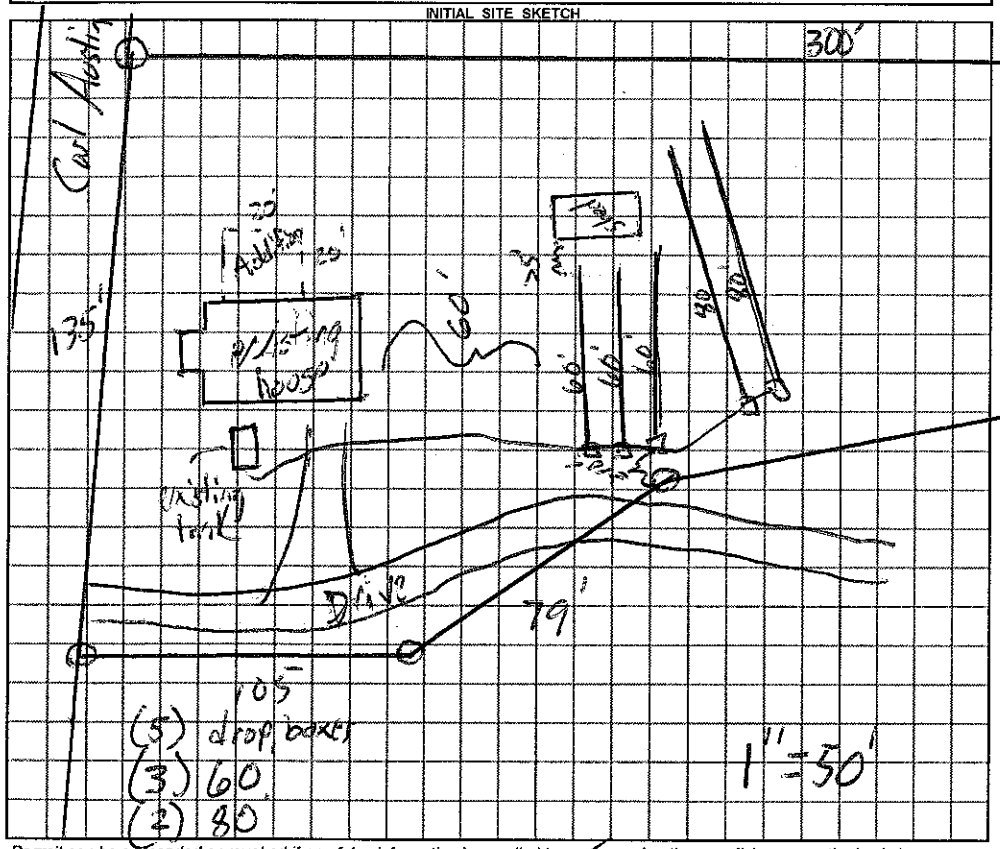

AS BUILT SKETCH

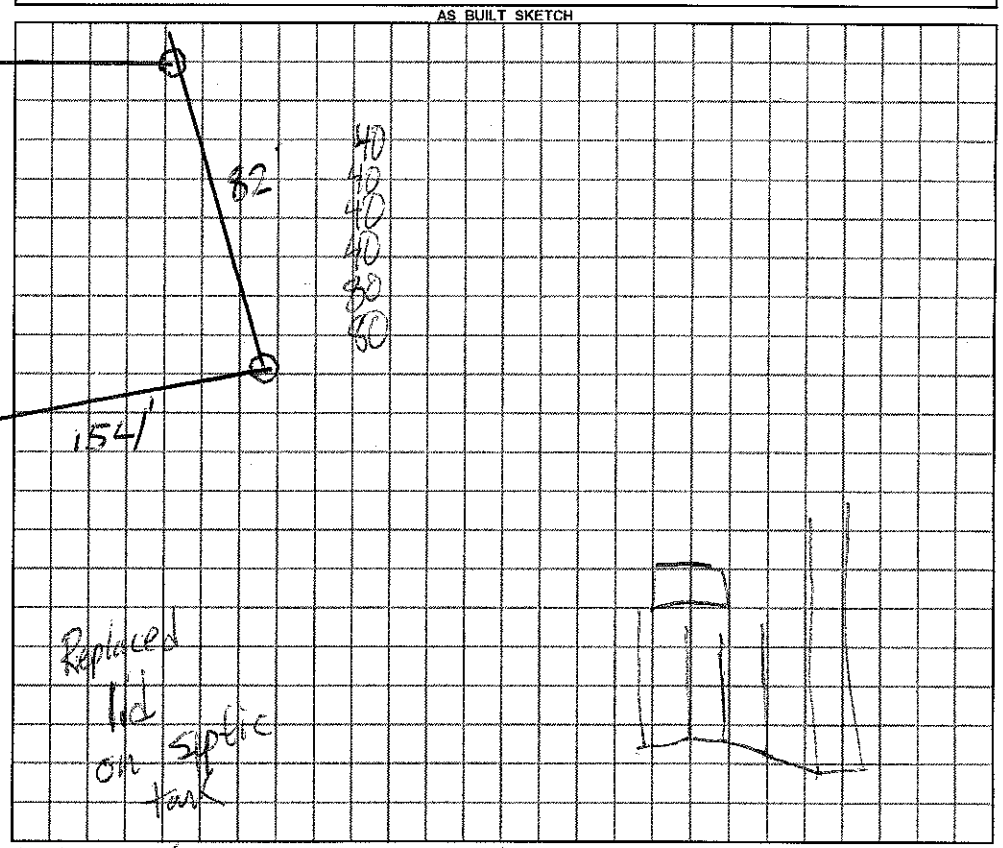

Permit can be suspended or revoked if any false information is supplied toward securing the permit / any unauthorized changes are made to the site / any unauthorized changes are made in the installation of the system.

☐ ***IMPROVEMENT PERMIT*** *with plot valid without expiration.* ☒ ***IMPROVEMENT PERMIT*** *with ~~plot valid without expiration.~~ site plan valid 60 mo.* ☒ ***AUTHORIZATION TO CONSTRUCT*** valid for period equal to IMPROVEMENT PERMIT--not to exceed 60 mo.

Owner / Applicant Signature: Date 6-23-11 Installed by: Madison Grading

IMPROVEMENT PERMIT by: REHS Date 6-23-11 OPERATION PERMIT by: REHS Date 7-5-11

AUTHORIZATION TO CONSTRUCT by: REHS Date 6-23-11 Existing System Inspected by: REHS Date

YOU SHOULD CONTACT A LOCATOR SERVICE PRIOR TO ANY EXCAVATION

White Copy – Environmental Health YELLOW COPY (Final) Owner / Applicant PINK COPY (Initial) Owner / Applicant