IREDELL COUNTY HEALTH DEPARTMENT

STATESVILLE 704-878-5305 MOORESVILLE 704-664-5281

IMPROVEMENT PERMIT / AUTHORIZATION TO CONSTRUCT / OPERATION PERMIT / EXISTING SYSTEM INSPECTION

PERMIT# 92875 PIN# 4756 24 2011 DATE 11/16/00

OWNER OR CONTRACTOR Spear Construction PHONE: Business (704) 636-7954 Home

ADDRESS 607 Adelson Ave Salisbury NC 28144

LOCATION 21N, R 3rd Sowers, R Crawford, L Brookview, on Lt

SUBDIVISION BLOCK / SECTION LOT LOT AREA .46 AC SITE CLASS PS DESIGN FLOW 360 L.T.A.R. 0.3

Septic Tank: 1000 Gallons; STB 825 Date 12/05/00
Pump Tank: Gallons; PT Date
Pump Make: Model Serial No.
Nitrification Field: No Fields 1 Square Feet 900 Linear Feet 300
No Lines 5@60' Trench Width 36" Max Trench Bottom Depth 36 Gravel Depth —

[X] New System [ ] Repair System Type: I, II, (III), IV, V, VI
System Description: Gravity 25% Red.
Repair System Description: Pump 25% Red
Maintenance Agreement Required: [ ] Yes [X] No


[X] House/Mod. Home No. Bedrooms 3
[ ] Mobile Home No. Bathrooms 2
[ ] Business No. Employees
[ ] Other
[X] Slab [ ] Crawl Space [ ] Basement w/plumbing [ ] Basement wo/plumbing

Water Supply: [ ] Individual [X] Public [ ] Community


Comments:/Conditions:

Comments:/Conditions: Filter Installed
Infiltrator Installed

INITIAL SITE SKETCH

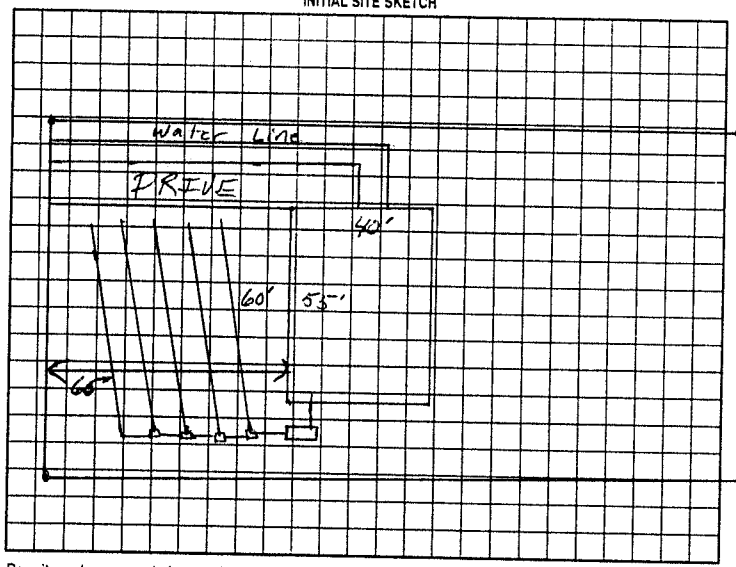

AS BUILT SKETCH

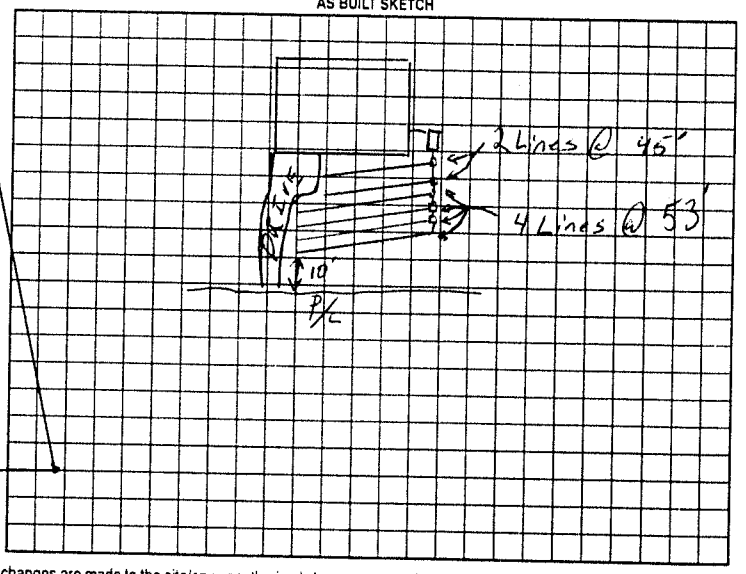

Permit can be suspended or revoked if any false information is supplied toward securing the permit/any unauthorized changes are made to the site/any unauthorized changes are made in the installation of the system. Improvement Permit with plat valid without expiration. Improvement Permit with site plan valid for sixty months. Authorization to Construct is valid for a period equal to that of Improvement Permit – not to exceed sixty months.

Signed: date 11/20/00

Improvement Permit by: RSE date 11/16/00

Authorization to Construct by: RSE date 11/16/00

Installed by: Rowan Septic

Operation Permit by: RSI date 1/17/01

Existing System Inspection by: date

HEALTH DEPT. COPY: WHITE OWNER COPY (FINAL): YELLOW OWNER COPY (INITIAL): PINK