IREDELL COUNTY HEALTH DEPARTMENT - *ENVIRONMENTAL HEALTH* ☑ STATESVILLE OFFICE 704-878-5305 ☐ MOORESVILLE OFFICE 704-664-5281

IMPROVEMENT PERMIT / AUTHORIZATION TO CONSTRUCT / OPERATION PERMIT / EXISTING SYSTEM INSPECTION

PERMIT # Repair PIN # 4756140409 DATE 9-7-12

OWNER Sarah Schemanske APPLICANT: Dennis Galliher PHONE: Home/Cell # 704-902-4015 Business # N/A

SITE ADDRESS 173 Danbury Ln. OWNER / APPLICANT ADDRESS 173 Danbury Ln.

SITE DIRECTIONS 64 E TL Jane Sawyer Rd. TR Danbury Ln 1st Lot on Right

SUBDIVISION Danbury Forest BLOCK / SECTION 51 LOT # 61 LOT AREA 0.41 acres DESIGN FLOW 360gpd L.T.A.R. Existing

Septic Tank 1000 Gallons: STB 760 Date 5-2 ☐ New System ☑ Repair ☐ Expansion System Type I II III IV V VI

Pump Tank ____ Gallons: P T ____ Date ____ System Description: ____

Pump Make ____ Model ____ Serial # ____ Repair System Description: Tank

No. Nitrification Fields: 1 No. Lines 2 Linear Feet Existing Maintenance Agreement Required ☐ YES ☑ NO


Trench Width Existing Max. Trench Bottom Depth Existing Gravel Depth Existing ☑ GRAVITY ☐ PRESSURE

☑ Residence No. Bedrooms 3 ☐ Business No. Persons ____ ☐ Other No. Employees ____ ☐ Slab ☑ Crawl Space ☐ Basement w/plumbing ☐ Basement w/o plumbing


Water Supply ☐ Private ☑ Public ☐ Community

Comments / Conditions: Pump + crush old septic tank. Set new septic tank + connect to existing drainfield
- Remove slab from covering all parts of septic tank system

INITIAL SITE SKETCH

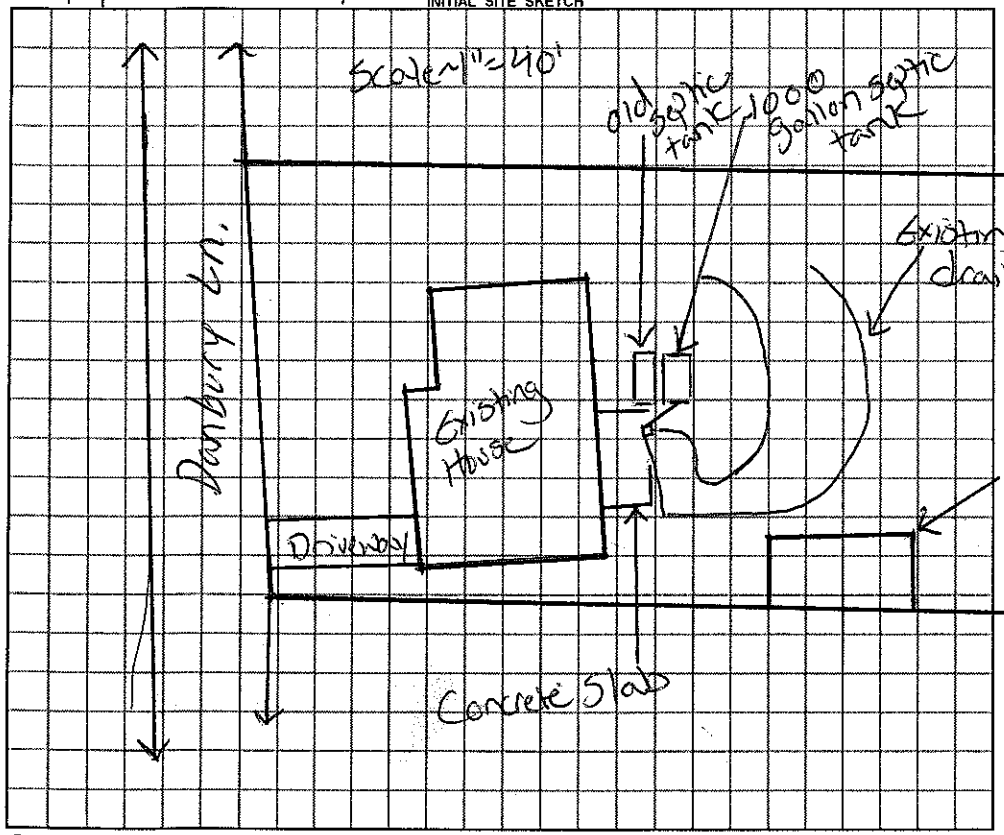

AS BUILT SKETCH

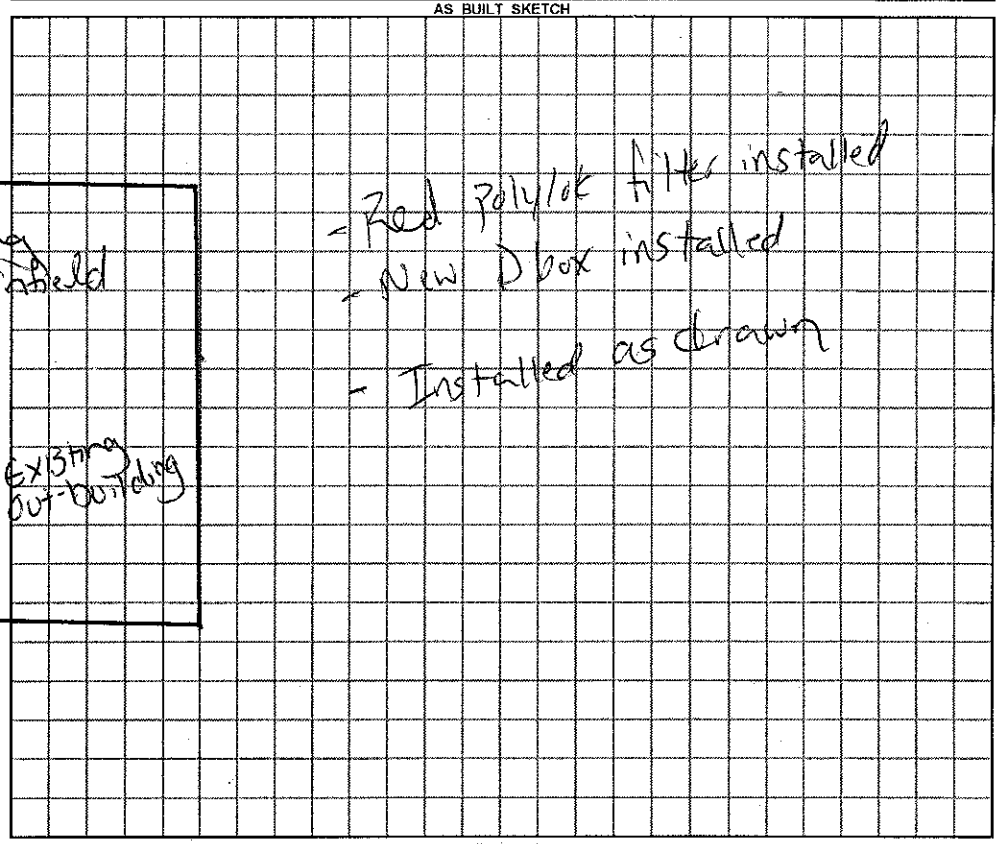

Permit can be suspended or revoked if any false information is supplied toward securing the permit / any unauthorized changes are made to the site / any unauthorized changes are made in the installation of the system.

☐ ***IMPROVEMENT PERMIT*** with plat valid without expiration. ☑ ***IMPROVEMENT PERMIT*** with plat valid without expiration. ☑ ***AUTHORIZATION TO CONSTRUCT*** valid for period equal to IMPROVEMENT PERMIT--not to exceed 60 mo.

Site plan valid

Owner / Applicant Signature: Dennis Galliher Date 9-11-12 Installed by: A1 Backhoe

IMPROVEMENT PERMIT by: Justin Henderson REHS Date 9-7-12 OPERATION PERMIT by: Justin Henderson REHS Date 9-11-12

AUTHORIZATION TO CONSTRUCT by: Justin Henderson REHS Date 9-7-12 Existing System Inspected by: ____ REHS Date ____

YOU SHOULD CONTACT A LOCATOR SERVICE PRIOR TO ANY EXCAVATION

White Copy -- Environmental Health YELLOW COPY (Final) Owner / Applicant PINK COPY (Initial) Owner / Applicant