2:00

IREDELL COUNTY HEALTH DEPARTMENT

STATESVILLE 704-878-5305 MOORESVILLE 704-664-5281

RSH

IMPROVEMENT PERMIT / AUTHORIZATION TO CONSTRUCT / OPERATION PERMIT / EXISTING SYSTEM INSPECTION

~~PERMIT #~~ Repair PIN # 4756-14-1054 DATE 16 October 09

OWNER or APPLICANT John R. CHOTKOWSKI PHONE: Business Home: (704) 876-1445

OWNER or APPLICANT ADDRESS 406 Jane Sowers Rd. Statesville, N.C.

LOCATION / DIRECTIONS Hwy 21 N TR Jane Sowers Rd. ON RT. before Crawford Rd.

SUBDIVISION BLOCK / SECTION LOT # LOT AREA 1.09ac. DESIGN FLOW 360gpd L.T.A.R. 0.3 gpd/ft²

Septic Tank Exist. Gallons: STB ~~6X~~ Date

Pump Tank Gallons: P T Date

Pump Make Model Serial #

Nitrification Field No Fields 1 No Lines 4 Linear Feet 300

Trench Width 36" Max. Trench Bottom Depth 36" Gravel Depth

☐ New System ☑ Repair ☐ Expansion System Type I II (III) IV V VI

System Description: 25% Reduction

Repair System Description:

Maintenance Agreement Required ☐ YES ☑ NO

☑ GRAVITY ☐ PRESSURE

☑ Residence No. Bedrooms 3

☐ Business No. Persons

☐ Other No. Employees

☐ Slab ☑ Crawl Space


☐ Basement w/plumbing ☐ Basement w/o plumbing

Water Supply: ☑ Private ☐ Public ☐ Community

Comments / Conditions: Follow contours / Keep 6' below exist. system / Replace tee in septic tank / Add 300 lf of 25% Reduction system to existing system.

Comments / Conditions

INITIAL SITE SKETCH

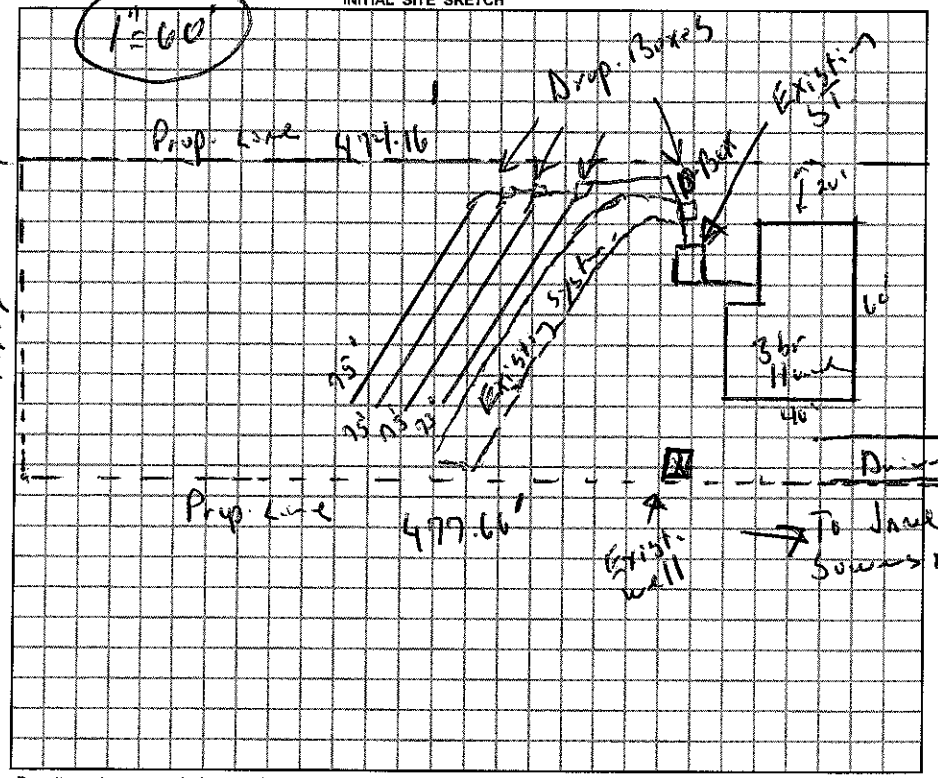

AS BUILT SKETCH

Permit can be suspended or revoked if any false information is supplied toward securing the permit / any unauthorized changes are made to the site / any unauthorized changes are made in the installation of the system.

☐ *IMPROVEMENT PERMIT w / plat valid without expiration.* ☑ *IMPROVEMENT PERMIT w / site plan valid for 60 mos.* ☑ *AUTHORIZATION TO CONSTRUCT valid for period equal to IMPROVEMENT PERMIT-not to exceed 60 mo.*

Owner / Applicant Signature: John Chotkowski Date 10-19-09

Improvement Permit by: Date

Authorization to Construct by: R.S. Date 10.21.09

Installed by: A-1 Backhoe

Operation Permit by: Date: 10-22-09

Existing System Inspected by: Date:

YOU SHOULD CONTACT A LOCATOR SERVICE PRIOR TO ANY EXCAVATION.

WHITE COPY Environmental Health YELLOW COPY (Final) Owner / Applicant PINK COPY (Initial) Owner / Applicant