IREDELL COUNTY HEALTH DEPARTMENT

STATESVILLE 704-878-5305 MOORESVILLE 704-664-5281

IMPROVEMENT PERMIT / AUTHORIZATION TO CONSTRUCT / OPERATION PERMIT / EXISTING SYSTEM INSPECTION

PERMIT # Repair PIN # 4756 14 4925 DATE May 17, 2011

OWNER or APPLICANT Brian Mahaney PHONE: Business 704 807 9655 Home:

OWNER or APPLICANT ADDRESS 18932 Victoria Bay Dr. [redacted] Cornelius NC

LOCATION / DIRECTIONS I-21 N TR Jane Sowers Rds x I-77 TL Danbury Ln. - TR Pineview Ct. TL Little Forest Lane 2nd house on Rt.

SUBDIVISION Danbury Forest BLOCK / SECTION LOT # 44 LOT AREA Ex DESIGN FLOW 360 gpd L.T.A.R.

Septic Tank 1000 Gallons: STB Date

Pump Tank Gallons: P T Date

Pump Make Model Serial #

Nitrification Field No Fields No Lines Linear Feet

Trench Width Existing Max. Trench Bottom Depth Gravel Depth

☐ New System ☒ Repair ☐ Expansion System Type I II III IV V VI

System Description: tank replacement - Conv. Conventional

Repair System Description:

Maintenance Agreement Required ☐ YES ☒ NO

☑ GRAVITY ☐ PRESSURE

☑ Residence No. Bedrooms 3

☐ Business No. Persons

☐ Other No. Employees

☐ Slab ☐ Crawl Space


☐ Basement w/plumbing ☐ Basement w/o plumbing

Water Supply: ☐ Private ☒ Public ☐ Community

Comments / Conditions: Maintain 5' from all Deck supports / footings with new tank. Pump out crush and fill in old septic tank. Replant from new tank to sewer 0-lot. Septic tank replacement only due to poor condition of existing tank.

Comments / Conditions

INITIAL SITE SKETCH

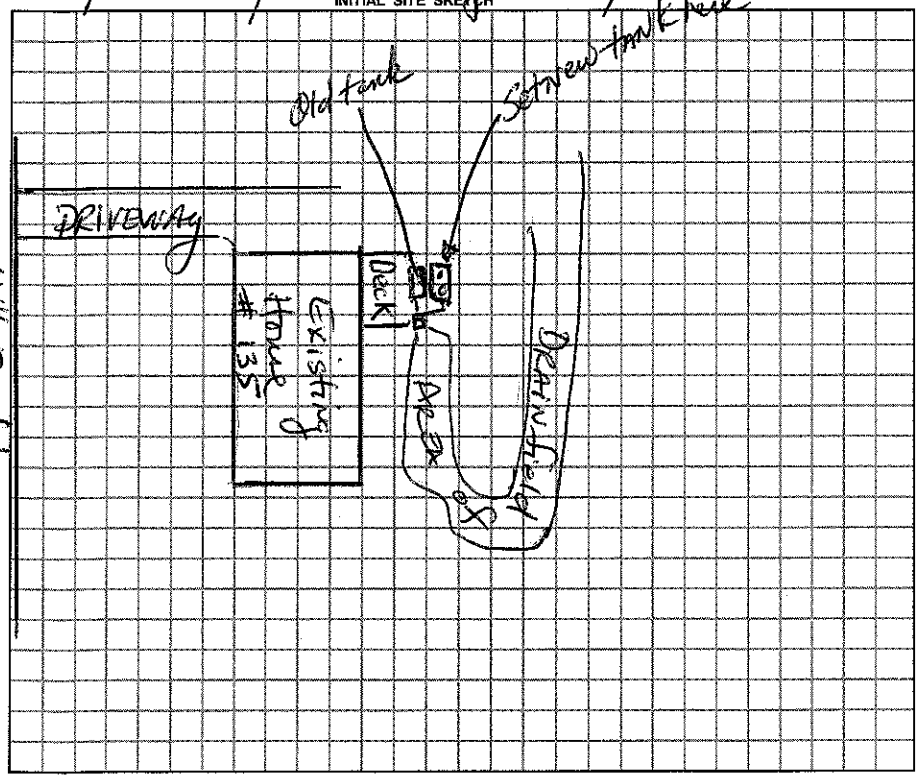

AS BUILT SKETCH

Permit can be suspended or revoked if any false information is supplied toward securing the permit / any unauthorized changes are made to the site / any unauthorized changes are made in the installation of the system.

☐ *IMPROVEMENT PERMIT w / plat valid without expiration.* ☑ *IMPROVEMENT PERMIT w / site plan valid for 60 mos.* ☑ *AUTHORIZATION TO CONSTRUCT valid for period equal to IMPROVEMENT PERMIT-not to exceed 60 mo.*

Owner / Applicant Signature: Date 5-17-11

Improvement Permit by: Date

Authorization to Construct by: Date 5-17-11

Installed by: A-1 Backhoe

Operation Permit by: Date: 5-24-11

Existing System Inspected by: Date:

YOU SHOULD CONTACT A LOCATOR SERVICE PRIOR TO ANY EXCAVATION.

WHITE COPY Environmental Health YELLOW COPY (Final) Owner / Applicant PINK COPY (Initial) Owner / Applicant