IREDELL COUNTY HEALTH DEPARTMENT

STATESVILLE 704-878-5305 MOORESVILLE 704-664-5281

IMPROVEMENT PERMIT / AUTHORIZATION TO CONSTRUCT / OPERATION PERMIT / EXISTING SYSTEM INSPECTION

PERMIT# REPAIR PIN# 4756-14-5344 DATE 6-30-2009

OWNER OR APPLICANT JANICE V. BINKLEY PHONE: Business 704-657-4155 Home

ADDRESS 3010 CREOLE WAY, PENSACOLA FL 32526-2930

LOCATION US 21 NORTH, TR JANE SOWERS ROAD HOUSE ON LEFT ACROSS FROM CRAWFORD ROAD

SUBDIVISION WILDWOOD PK BLOCK / SECTION LOT 1 LOT AREA 100' x 200' SITE CLASS. PS DESIGN FLOW 360 L.T.A.R. EXISTING

Septic Tank: 1000 Gallons; STB 760 Date 3-23-09

Pump Tank: Gallons; PT Date

Pump Make: Model Serial No.

Nitrification Field: No Fields 1 Square Feet Linear Feet EXISTING

No Lines EXISTING Trench Width Max Trench Bottom Depth Gravel Depth

☐ New System ☑ Repair ☐ Expansion System Type: I (II) III IV V VI

System Description:

Repair System Description: CONVENTIONAL, GRAVITY

Maintenance Agreement Required: ☐ Yes ☑ No

☑ House/Mod. Home No. Bedrooms 3

☐ Mobile Home No. Persons

☐ Business No. Employees

☐ Other


Water Supply: ☐ Individual ☑ Public ☐ Community

☑ Gravity ☐ Pressure ☐ Slab ☑ Crawl Space ☐ Basement w/plumbing ☐ Basement wo/plumbing


Comments:/Conditions: REPLACE EXISTING DISTRIBUTION BOX AND SEPTIC TANK AS SHOWN.

Comments:/Conditions: Red Top Tire

INITIAL SITE SKETCH

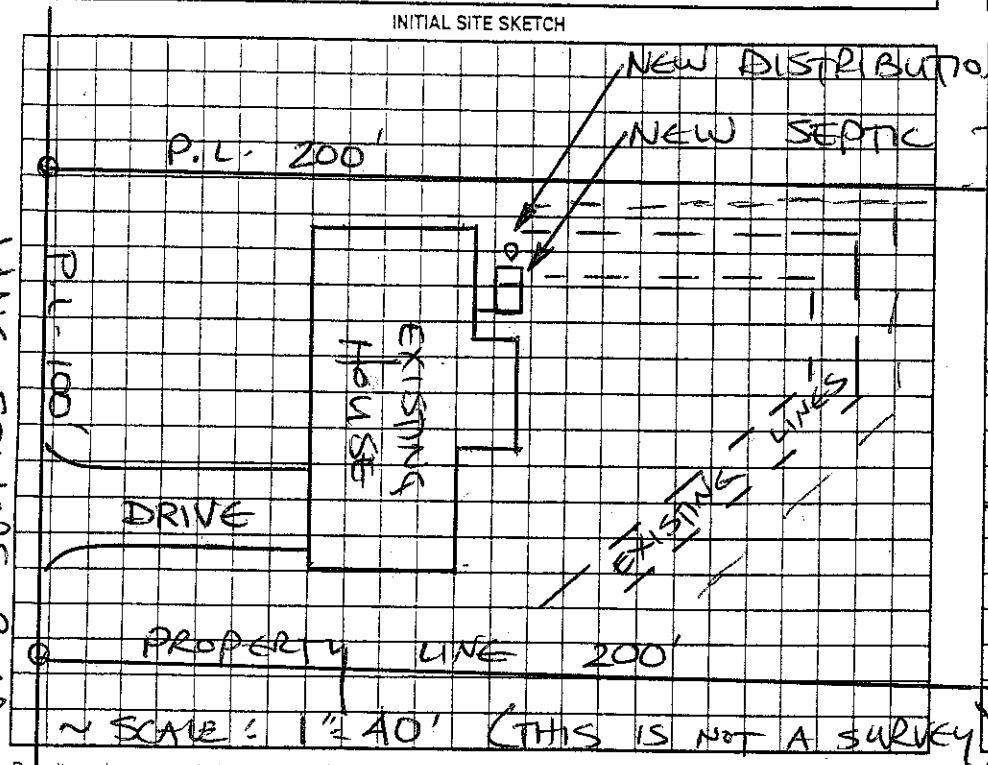

AS BUILT SKETCH

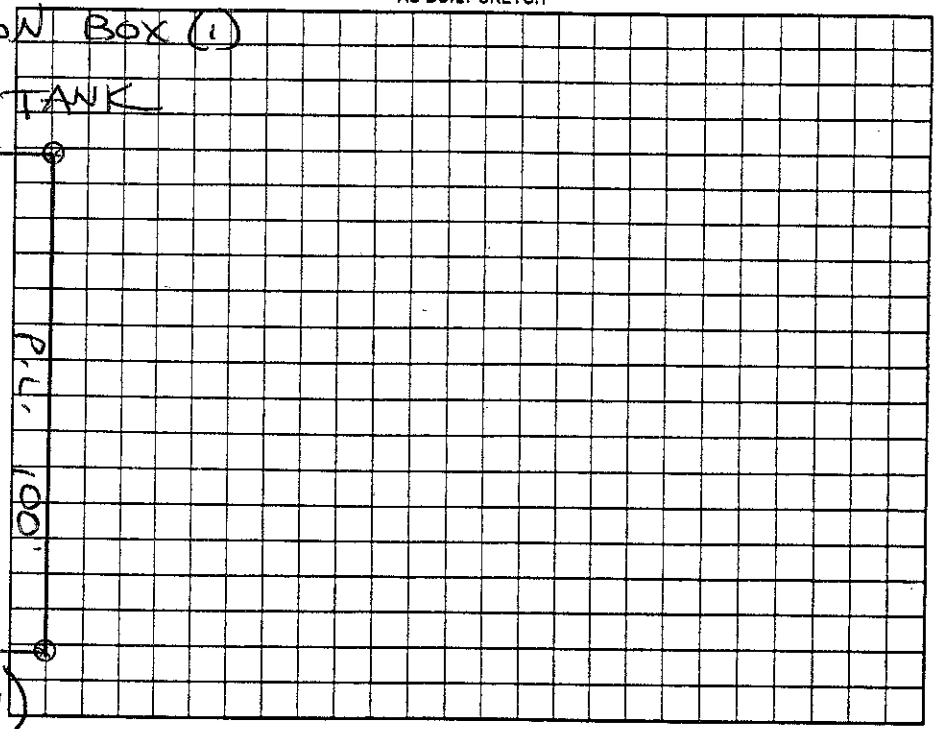

Permit can be suspended or revoked if any false information is supplied toward securing the permit/any unauthorized changes are made to the site/any unauthorized changes are made in the installation of the system. Improvement Permit with plat valid without expiration ☐ Improvement Permit with site plan valid for sixty months ☑ Authorization to Construct is valid for a period equal to that of Improvement Permit – not to exceed sixty months.

Signed: Beverly Hook date 6-30-09

Improvement Permit by: STEVE HEDRICK date 6.30.09

Authorization to Construct by: STEVE HEDRICK date 6.30.09

Installed by: Shaw

Operation Permit by: Kenneth Cook date 7-8-09

Existing System Inspection by: date

HEALTH DEPT. COPY: WHITE OWNER COPY (FINAL): YELLOW OWNER COPY (INITIAL): PINK