IREDELL COUNTY HEALTH DEPARTMENT - *ENVIRONMENTAL HEALTH* ☐ STATESVILLE OFFICE 704-878-5305 ☐ MOORESVILLE OFFICE 704-664-5281

IMPROVEMENT PERMIT / AUTHORIZATION TO CONSTRUCT / OPERATION PERMIT / EXISTING SYSTEM INSPECTION

PERMIT # EXEMPT PIN # 4756-14-5344 DATE JULY 19, 2011

OWNER TERESA STORY APPLICANT: PHONE: Home/Cell # 650-450-3493 Business # 510-676-0048

SITE ADDRESS 425 JANE SOWERS RD, STL OWNER / APPLICANT ADDRESS

SITE DIRECTIONS US 21 NORTH, TR JANE SOWERS ROAD, HOUSE ON LEFT AT BOX # 425

SUBDIVISION WILDWOOD PARK BLOCK / SECTION 1 - LOT # 1-4 LOT AREA 100 x 200' DESIGN FLOW 360 L.T.A.R. EXISTING


Septic Tank 1000	Gallons: STB	Date	☐ New System ☐ Repair ☐ Expansion System Type ☐ II ☐ III ☐ IV ☐ V ☐ VI	☑ Residence	No. Bedrooms 3	Water Supply
Pump Tank	Gallons: P T	Date	System Description: CONVENTIONAL, GRAVITY	☐ Business	No. Persons	☐ Private
Pump Make	Model	Serial #	Repair System Description:	☐ Other	No. Employees	☐ Public
No. Nitrification Fields: 1	No. Lines 1	Linear Feet EXISTING	Maintenance Agreement Required ☐ YES ☑ NO	☐ Slab	☐ Crawl Space	☐ Community
Trench Width BED	Max. Trench Bottom Depth	Gravel Depth	☑ GRAVITY ☐ PRESSURE	☐ Basement w/plumbing	☐ Basement w/o plumbing	

Comments / Conditions For underground antenna.

① KEEP OUTBUILDING MINIMUM 5' FROM SYSTEM
② ANTENNA TOWER MAY BE CONSTRUCTED ADJACENT TO DRAINFIELD ③ UNDERGROUND WIRE TO BE BURIED NO DEEPER THAN 12".

INITIAL SITE SKETCH

AS BUILT SKETCH

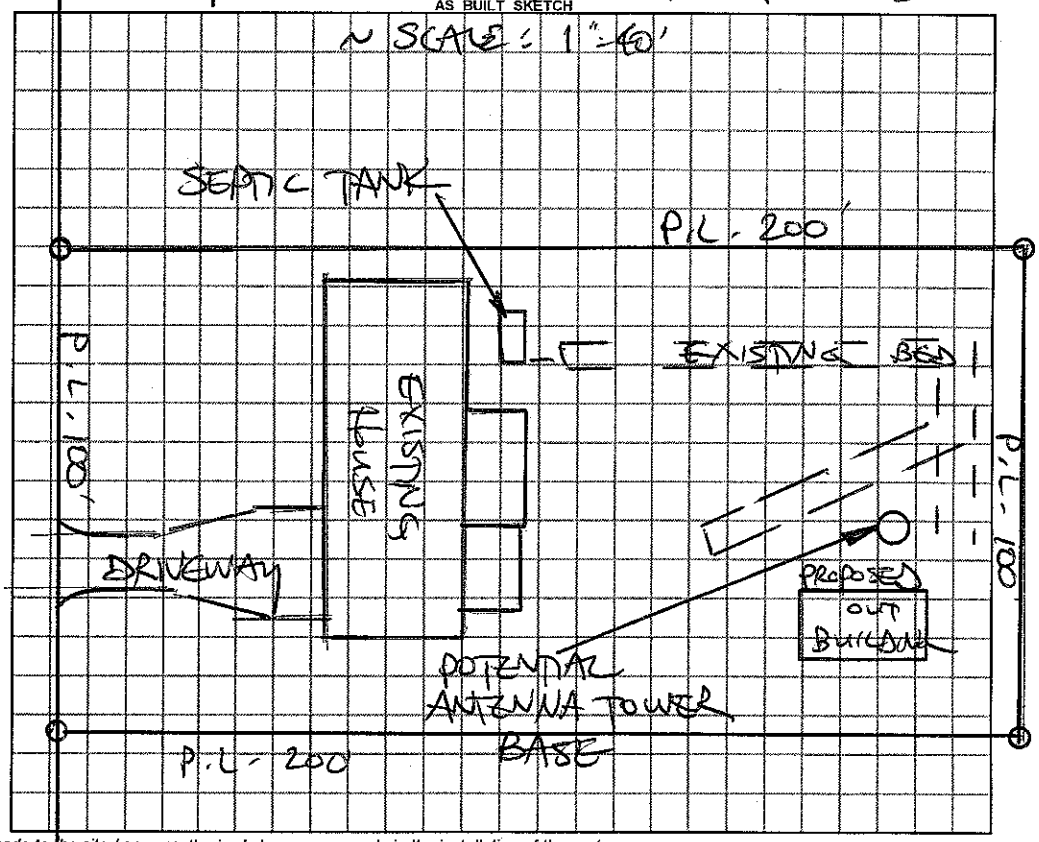

Permit can be suspended or revoked if any false information is supplied toward securing the permit / any unauthorized changes are made to the site / any unauthorized changes are made in the installation of the system.

☐ ***IMPROVEMENT PERMIT*** with plat valid without expiration. ☐ ***IMPROVEMENT PERMIT*** with ~~plat valid without expiration~~ site plan valid 60 mo. ☐ ***AUTHORIZATION TO CONSTRUCT*** valid for period equal to IMPROVEMENT PERMIT--not to exceed 60 mo.

Owner / Applicant Signature: Date Installed by:

IMPROVEMENT PERMIT by: REHS Date OPERATION PERMIT by: REHS Date

AUTHORIZATION TO CONSTRUCT by: REHS Date Existing System Inspected by: STEVE HEDRICK REHS Date 7-19-2011

YOU SHOULD CONTACT A LOCATOR SERVICE PRIOR TO ANY EXCAVATION

White Copy – Environmental Health YELLOW COPY (Final) Owner / Applicant PINK COPY (Initial) Owner / Applicant