IREDELL COUNTY HEALTH DEPARTMENT

STATESVILLE 704-878-5305 MOORESVILLE 704-664-5281

IMPROVEMENT PERMIT / AUTHORIZATION TO CONSTRUCT / OPERATION PERMIT / EXISTING SYSTEM INSPECTION

PERMIT# REPAIR PIN# 4756-14-8323 DATE 2-11-08

OWNER OR APPLICANT NEMPSON LEONARD HUGHES PHONE: Business 704-546-2583 Home 704-876-3862

ADDRESS 439 JANE SOWERS ROAD STATESVILLE, NC 28625-8970

LOCATION US 21 NORTH, TR JANE SOWER RD HOUSE ON LEFT AT WILDWOOD LOOP AT # 439

SUBDIVISION WILDWOOD BLOCK / SECTION LOT 105-108 LOT AREA 1 ACRE SITE CLASS PS DESIGN FLOW 240 L.T.A.R. 0.30 GPD/FT2

Septic Tank: EXISTING Gallons: STB Date

Pump Tank: Gallons: PT Date

Pump Make: Model EQ PS Serial No.

Nitrification Field: No Fields 1 Square Feet 600 Linear Feet 150

No Lines TWO Trench Width 36" Max Trench Bottom Depth 36 +/- Gravel Depth N/A

☐ New System ☑ Repair ☐ Expansion System Type: I II (III) IV V VI

System Description:

Repair System Description: 25% REDUCTION, GRAVITY

Maintenance Agreement Required: ☐ Yes ☑ No

☑ Gravity ☐ Pressure

☑ House/Mod. Home No. Bedrooms 2

☐ Mobile Home No. Persons

☐ Business No. Employees

☐ Other


Water Supply: ☐ Individual ☑ Public ☐ Community

☐ Slab ☑ Crawl Space ☐ Basement w/plumbing ☐ Basement wo/plumbing


Comments:/Conditions: INSTALL 25% REDUCTION SYSTEM AS SHOWN, AS SHALLOW AS POSSIBLE.

Comments:/Conditions: NEW SANITARY TEE INSTALLED IN SEPTIC TANK

INITIAL SITE SKETCH

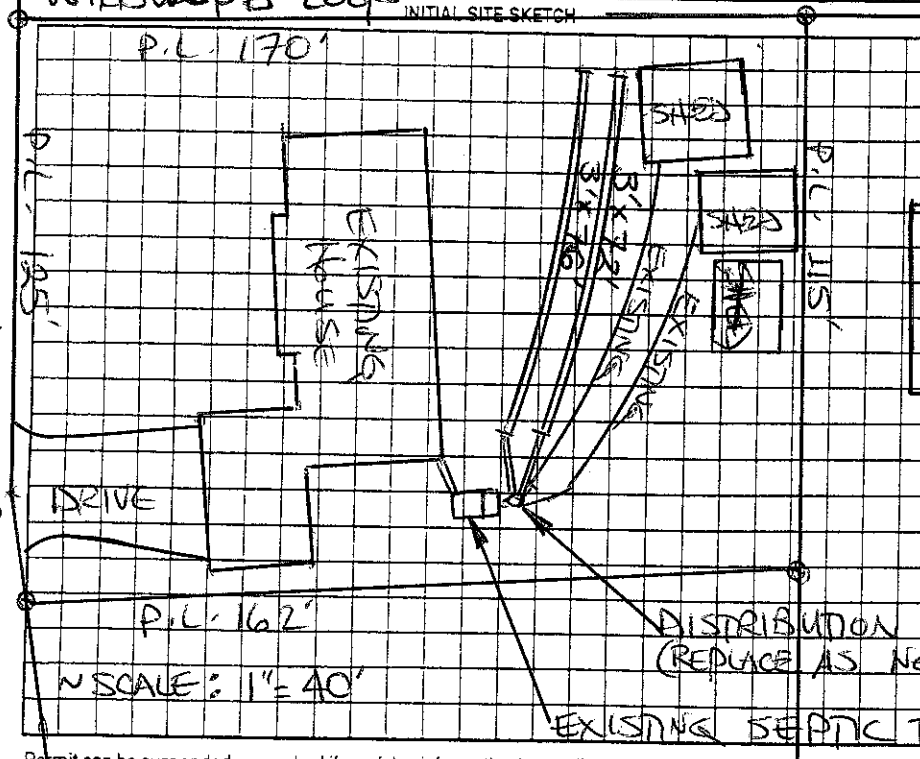

AS BUILT SKETCH

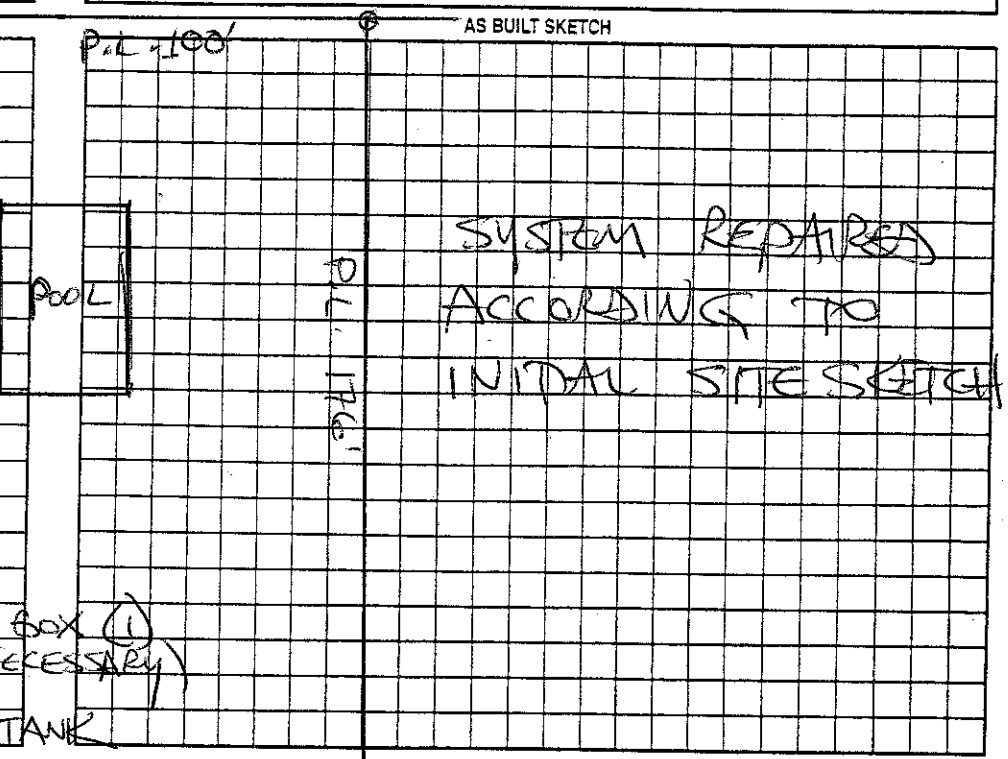

Permit can be suspended or revoked if any false information is supplied toward securing the permit/any unauthorized changes are made to the site/any unauthorized changes are made in the installation of the system. Improvement Permit with plat valid without expiration ☐ Improvement Permit with site plan valid for sixty months ☑ Authorization to Construct is valid for a period equal to that of Improvement Permit – not to exceed sixty months.

Signed: Ken Nyhan date 2-11-08

Improvement Permit by: STEVE HENDRICK date 2-11-08

Authorization to Construct by: STEVE HENDRICK date 2-11-08

Installed by: PIEDMONT BACKHOE

Operation Permit by: STEVE HENDRICK date 3-3-08

Existing System Inspection by: date

HEALTH DEPT. COPY: WHITE OWNER COPY (FINAL): YELLOW OWNER COPY (INITIAL): PINK