IREDELL COUNTY HEALTH DEPARTMENT

STATESVILLE 704-878-5305 MOORESVILLE 704-664-5281 46834

IMPROVEMENT PERMIT / CERTIFICATE OF COMPLETION / OPERATION PERMIT / EXISTING SYSTEM INSPECTION

PROPERTY DESCRIPTION NO. 6114 DATE 12-2-93 TAX MAP NO. 106-5-B-35 Watershed: ☐ Yes ☑ No

OWNER OR CONTRACTOR Jerry Harkey PHONE: Business Home

ADDRESS 21 N TR Jane Sowers TL Wildwood Loop TL Imperial Drive 1/4mi on left

LOCATION

SUBDIVISION Wildwood BLOCK / SECTION LOT 239 LOT AREA 1.72acres SITE CLASS. P5 DESIGN FLOW 480 L.T.A.R. .4

Septic Tank: 1000 Gallons; STB 356 Date 10-25-93
Pump Tank: Gallons; PT Date
Pump Make: Model Serial No.
Nitrification Field. No Fields 1 Square Feet 1200 Linear Feet 400
No Lines 4 Trench Width 36" Max Trench Bottom Depth 36" Gravel Depth 12"

☑ New System ☐ Repair System Type: I, II, III, IV, V, VI
System Description: Conv Gravity
Repair System Description: " "
Maintenance Agreement Required: ☐ Yes ☑ No


☐ House/Mod. Home No. Bedrooms 4
☐ Mobile Home No. Bathrooms 2½
☑ Business No. Employees
☐ Other
☐ Slab ☐ Crawl Space ☑ Basement w/plumbing ☐ Basement wo/plumbing

Water Supply: ☐ Individual ☐ Community ☑ Public


Comments:

Comments:

INITIAL SITE SKETCH

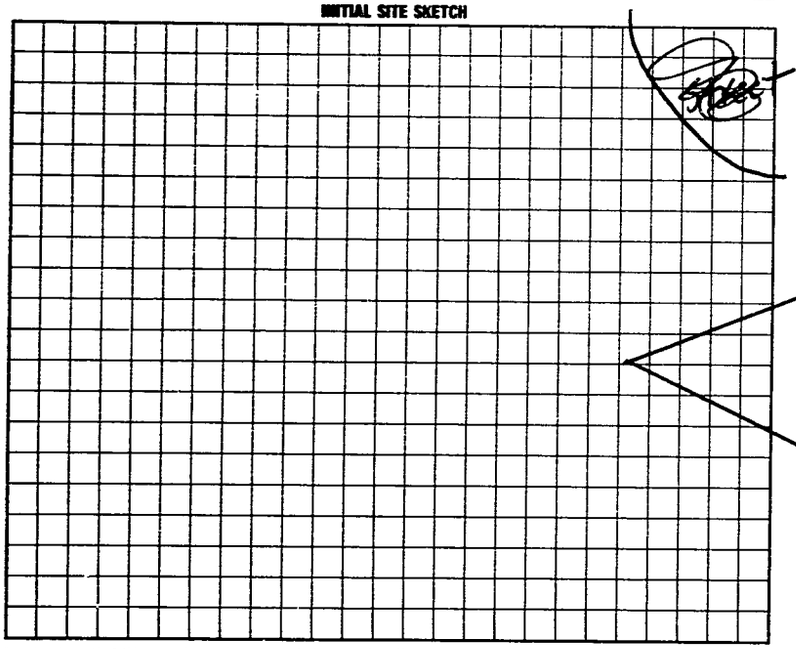

AS BUILT SKETCH

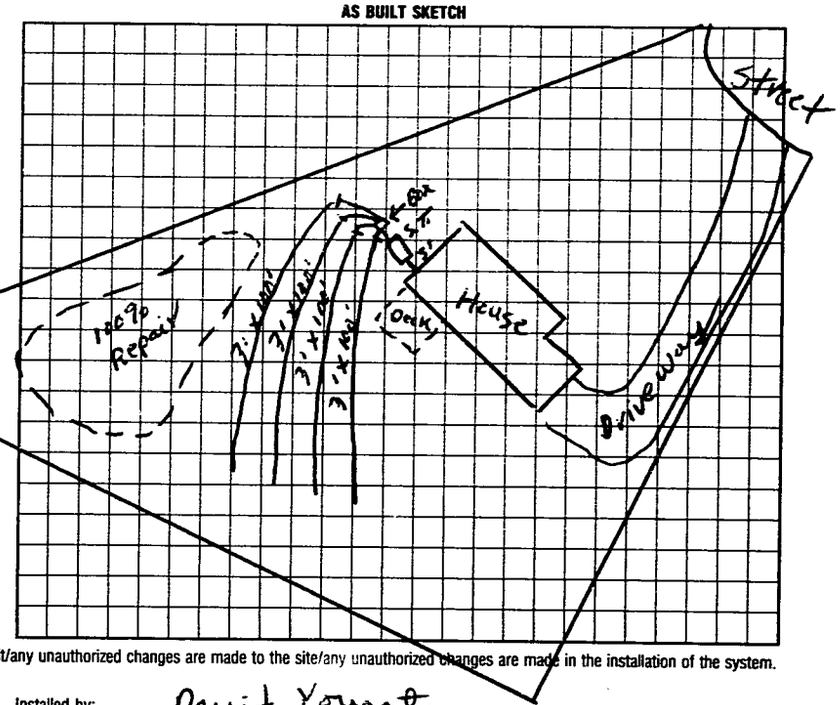

I understand that this permit can be suspended or revoked if any false information is supplied toward securing the permit/any unauthorized changes are made to the site/any unauthorized changes are made in the installation of the system. Improvement Permit is valid for 60 months from date of issuance.

Signed:

Improvement Permit by: J. C. Moore date 4-8-93

Existing System Inspection by: date

Installed by: David Yount

Certificate of Completion by: J. C. Moore date 12-2-93

Operation Permit by: date

HEALTH DEPT. COPY: WHITE INSPECTION COPY (FINAL): GREEN OWNER COPY (FINAL): YELLOW INSPECTION COPY (INITIAL): PINK OWNER COPY (INITIAL): GOLD