IREDELL COUNTY HEALTH DEPARTMENT

STATESVILLE 704-878-5305 MOORESVILLE 704-664-5281

IMPROVEMENT PERMIT / AUTHORIZATION TO CONSTRUCT / OPERATION PERMIT / EXISTING SYSTEM INSPECTION

PERMIT# 103282 PIN# 4756-23-0973 DATE 11-30-01

OWNER OR CONTRACTOR TSUMAS FAMILY LTD PARTNERSHIP PHONE: Business 704-878-9171 Home

ADDRESS 300 E BROAD ST SUITE 102 STATESVILLE NC 28677

LOCATION JANE SOWERS, ®CRAWFORD ©BROOKVIEW ON LEFT 2ND LOT PAST CHURCH

SUBDIVISION BRANTWOOD BLOCK / SECTION LOT 6 LOT AREA .51 SITE CLASS PS DESIGN FLOW 360 L.T.A.R. .3

Septic Tank: 1600 Gallons: STB 825 Date 12-15-01
Pump Tank: Gallons; PT Date
Pump Make: Model Serial No
Nitrification Field: No Fields 1 Square Feet 1200' Linear Feet 400'
No Lines 7X57' Trench Width 36" Max Trench Bottom Depth 36"

X New System ☐ Repair System Type: I, (II), III, IV, V, VI
System Description: CONV GRA-1
Repair System Description: PUMP PANEL / LP PANEL
Maintenance Agreement Required: ☐ Yes X No
Gravel Depth 12" X Slab ☐ Crawl Space ☐ Basement w/plumbing ☐ Basement wo/plumbing


X House/Mod. Home No. Bedrooms 3
☐ Mobile Home No. Bathrooms 2
☐ Business No. Employees
☐ Other

Water Supply: ☐ Individual X Public ☐ Community

Comments:/Conditions: ①MAINTAIN SETBACKS ②KEEP H2O LINE 10' FROM SYSTEM ③INSTALL LINES ON CONTOURS ④HOUSE NEEDS TO BE 115' FROM ROAD PINS.

Comments:/Conditions. SEPTIC TANK WITH MARKER INSTALLED USING "Polylok" FILTER

INITIAL SITE SKETCH 1" = 50'

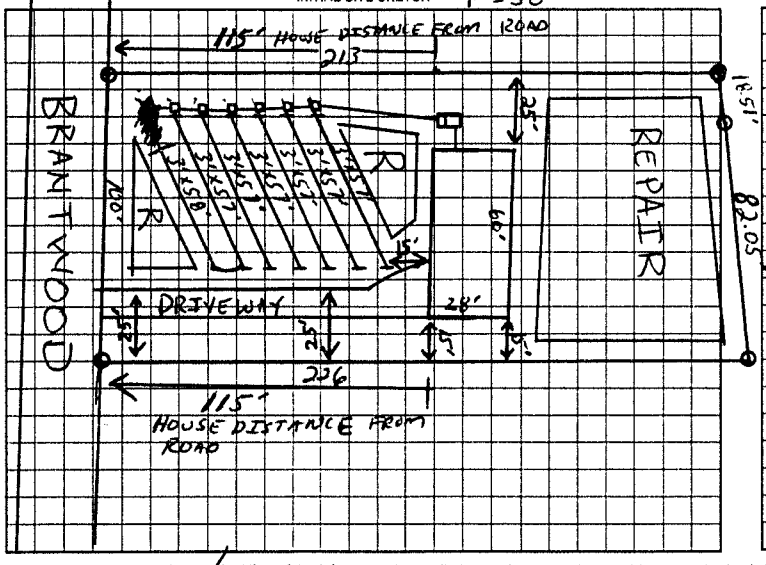

AS BUILT SKETCH

SYSTEM INSTALLED AS SHOWN DURING PERIOD OF WET SOIL CONDITIONS

Permit can be suspended or revoked if any false information is supplied toward securing the permit/any unauthorized changes are made to the site/any unauthorized changes are made in the installation of the system. Improvement Permit with plat valid without expiration. Improvement Permit with site plan valid for sixty months. Authorization to Construct is valid for a period equal to that of Improvement Permit – not to exceed sixty months.

Signed: date 12/2/01 Installed by: ROWAN SEPTIC TANK

Improvement Permit by: date 11-30-01 Operation Permit by: STEVE HENDRICK date 2-11-02

Authorization to Construct by: date 11-30-01 Existing System Inspection by: date

HEALTH DEPT. COPY: WHITE OWNER COPY (FINAL): YELLOW OWNER COPY (INITIAL): PINK