AC CF CF

IREDELL COUNTY HEALTH DEPARTMENT

STATESVILLE 704-878-5305 MOORESVILLE 704-664-5281

IMPROVEMENT PERMIT / AUTHORIZATION TO CONSTRUCT / OPERATION PERMIT / EXISTING SYSTEM INSPECTION

PERMIT# 103281 PIN# 4756-23-1973 DATE 11-28-01

OWNER OR CONTRACTOR SPEAR CONST / TSUMAS FAMILY PHONE: Business 704-878-9171 Home

ADDRESS 300 E BROAD ST SUITE 102 STATESVILLE NC 28677

LOCATION JANE SOWERS, (R) CRAWFORD, (L) BROOKVIEW, 3RD LOT ON LEFT PAST CHURCH

SUBDIVISION BRANTWOOD BLOCK / SECTION LOT 5 LOT AREA 0.5336 SITE CLASS PS DESIGN FLOW 360 L.T.A.R. .5

Septic Tank: 1000 Gallons; STB 825 Date 11-13-01
Pump Tank: Gallons; PT Date
Pump Make: Model Serial No.
Nitrification Field: No Fields 1 Square Feet 1200' Linear Feet 400'
No Lines 7x57' Trench Width 36" Max Trench Bottom Depth 36" Gravel Depth 12"

[X] New System [ ] Repair System Type: I, [II], III, IV, V, VI
System Description: 6 CAY CONV
Repair System Description: PUMP PANEL / 25% REDUCT
Maintenance Agreement Required: [ ] Yes [X] No

[X] House/Mod. Home No. Bedrooms 3
[ ] Mobile Home No. Bathrooms 2
[ ] Business No. Employees
[ ] Other


[X] Slab [ ] Crawl Space [ ] Basement w/plumbing [ ] Basement wo/plumbing

Water Supply: [ ] Individual [X] Public [ ] Community

Comments/Conditions: (1) KEEP H2O LINE 10' FROM SYSTEM (2) MAINTAIN SETBACKS (3) INSTALL LINES ON CONTOURS USE 6 DROP BOXES

Comments/Conditions: POLYLOK FILTER & MARKER INSTALLED AS SHOWN

INITIAL SITE SKETCH 1"=50'

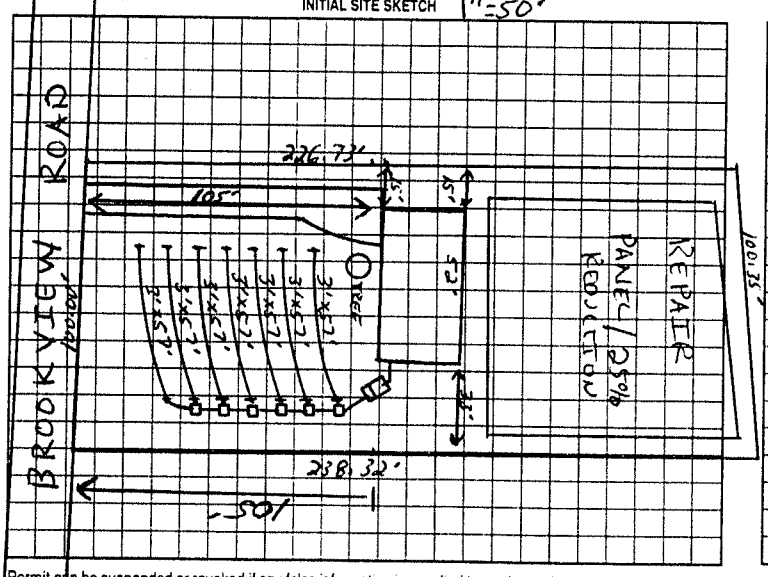

AS BUILT SKETCH

Permit can be suspended or revoked if any false information is supplied toward securing the permit/any unauthorized changes are made to the site/any unauthorized changes are made in the installation of the system. Improvement Permit with plat valid without expiration. Improvement Permit with site plan valid for sixty months. Authorization to Construct is valid for a period equal to that of Improvement Permit – not to exceed sixty months.

Signed: date 11/28/01 Installed by: ROWAN SEPTIC

Improvement Permit by: Jim Cook RS date 11-28-01 Operation Permit by: Jim Cook RS date 01-15-02

Authorization to Construct by: Jim Cook RS date 11-28-01 Existing System Inspection by: date

HEALTH DEPT. COPY: WHITE OWNER COPY (FINAL): YELLOW OWNER COPY (INITIAL): PINK