IREDELL COUNTY HEALTH DEPARTMENT

STATESVILLE 704-878-5305 MOORESVILLE 704-664-5281

IMPROVEMENT PERMIT / AUTHORIZATION TO CONSTRUCT / OPERATION PERMIT / EXISTING SYSTEM INSPECTION

PERMIT# 10160[redacted] PIN# 4756-23-3974 DATE 7-18-01

OWNER OR CONTRACTOR SPEAR CONSTRUCTION PHONE: Business _____ Home 704-636-7954

ADDRESS 607 ANDERSON AVENUE, SALISBURY, NC 28625

LOCATION HWY 21 N, (R) JANE SOWERS, (R) CRAWFORD, (L) BROOKVIEW, ¼ mile on LFT

SUBDIVISION BRAINTWOOD BLOCK / SECTION _____ LOT 3 LOT AREA .59 AC SITE CLASS PS DESIGN FLOW 360 L.T.A.R. .3

Septic Tank: 1000 Gallons; STB 825 Date 10-8-01
Pump Tank: _____ Gallons; PT _____ Date _____
Pump Make: _____ Model _____ Serial No. _____
Nitrification Field: No Fields 1 Square Feet EQ=1200 Linear Feet 300'
No Lines 4 Trench Width 36" Max Trench Bottom Depth 36"

[X] New System [ ] Repair System Type: I, II, (III), IV, V, VI (RED)
System Description: GRAV 25% RED / FRENCH
Repair System Description: LP PANEL
Maintenance Agreement Required: [ ] Yes [X] No
Gravel Depth 12" [ ] Slab [X] Crawl Space [ ] Basement w/plumbing [ ] Basement wo/plumbing


[X] House/Mod. Home No. Bedrooms 3
[ ] Mobile Home No. Bathrooms 2
[ ] Business No. Employees _____
[ ] Other _____

Water Supply: [ ] Individual [X] Public [ ] Community

Comments/Conditions: (1) INSTALL FRENCH DRAIN 25' BELOW NEIGHBORS SYSTEM, 10' ABOVE NEW SYSTEM & HAVE FALL TO THE ROAD. (2) INSTALL SUMP PUMP & BASIN AS CLOSE TO FRONT PROPERTY LINE AS POSSIBLE & HAVE OUTLET IN DITCH.

Comments/Conditions: (3) MAINTAIN SETBACKS (4) PERMIT CAN NOT BE SIGNED OFF UNTIL NEEDED TRAIT EASEMENT FOR LOT 1 HAS BEEN COMPLETED POLYLOK FILTER & MARKER

INITIAL SITE SKETCH

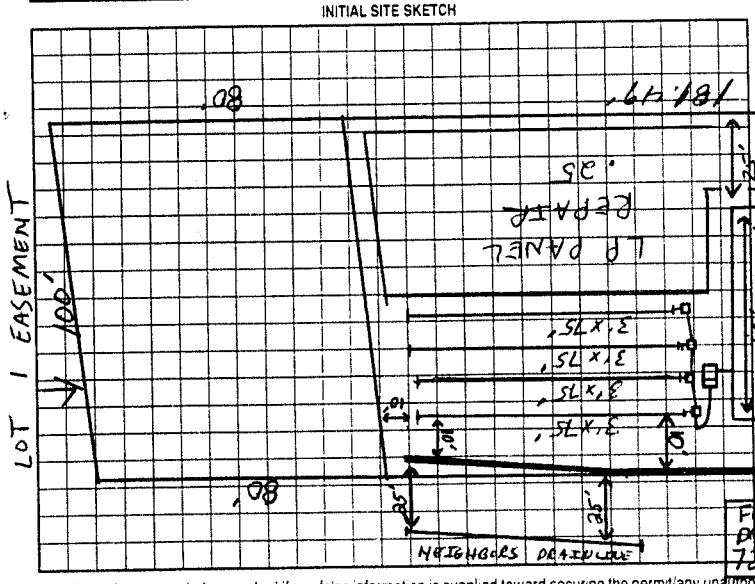

AS BUILT SKETCH

TOLD ON 11-26-01, BEFORE SLAB WAS POURED, THAT STUBOUT WAS IN WRONG PLACE & MAY HAVE TO BE CHANGED TO PUMP! LC

IF DITCH IS DEEPER THAN 36" FIRST TWO LINES CHECKED & FRENCH DRAIN CHECKED POLYLOK FILTER 12-5-01

(X) EVERYTHING CHECKED OUT SUMP PUMP - NEED TO SEE ELECTRICAL RECEPTACLE (GFI ISSUE OK) FOR SUMP IN JUNCTION HOUSE & SEE PUMP WORK LC 12-5-01

Permit can be suspended or revoked if any false information is supplied toward securing the permit/any unauthorized changes are made to the site/any unauthorized changes are made in the installation of the system. Improvement Permit with plat valid without expiration. Improvement Permit with site plan valid for sixty months. Authorization to Construct is valid for a period equal to that of Improvement Permit - not to exceed sixty months.

Signed: _____ date 7/19/01 Installed by: ROWAN SEPTIC

Improvement Permit by: Jim Cook REHS date 7-18-01 Operation Permit by: Jim Cook RS date 01-14-02

Authorization to Construct by: Jim Cook REHS date 7-18-01 Existing System Inspection by: _____ date _____

HEALTH DEPT COPY WHITE OWNER COPY (FINAL) YELLOW OWNER COPY (INITIAL) PINK